


RECEIVED

ASOTIN CO., WASHINGTON  
WALLOWA CO., OREGON  
MAR 21 1995  
WATER RESOURCES DEPT  
SALEM, OREGON 17

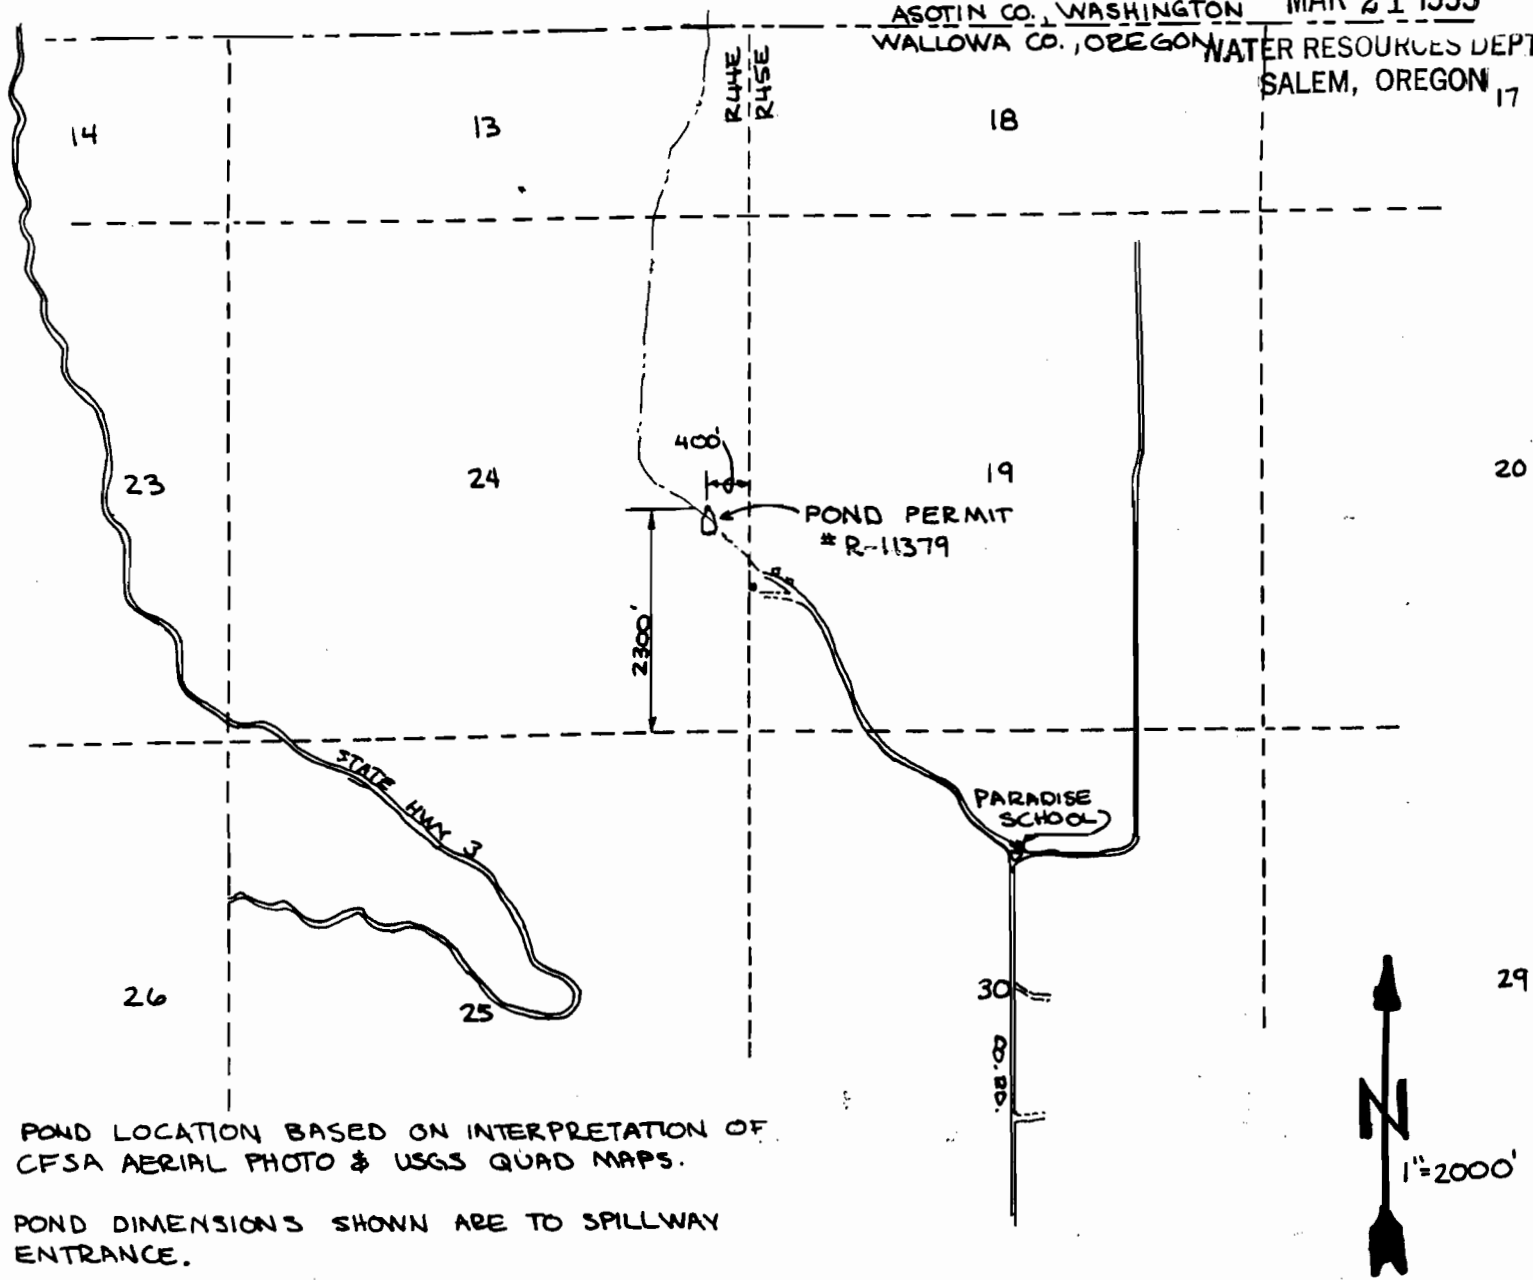

POND LOCATION BASED ON INTERPRETATION OF  
CFSA AERIAL PHOTO & USGS QUAD MAPS.

POND DIMENSIONS SHOWN ARE TO SPILLWAY  
ENTRANCE.

POND HAS SURFACE AREA OF 0.6 ACRE  
AND STORES 4.0 ACRE-FT.

SEE ATTACHED SITE REPORT

IN SECTION 24  
T6N, R44E, W.M.

NOTE:

THIS MAP IS PREPARED FOR WATER RIGHT  
PURPOSES ONLY AND SHOULD NOT BE  
USED FOR PROPERTY LINE LOCATION.



IN SECTION 24, T6N, R44E, WM  
WALLOWA COUNTY


FINAL PROOF MAP  
POND PERMIT #R-11379  
TEJAN, INC

RECEIVED

MAR 21 1995

WATER RESOURCES DEPT.  
SALEM, OREGON

REFERENCE POINT SHOWN ON  
FINAL PROOF MAP IS 400 FT WEST  
AND 2300 FT NORTH OF S.E. CORNER  
OF SECTION 24, T6N, R44E, W.M.

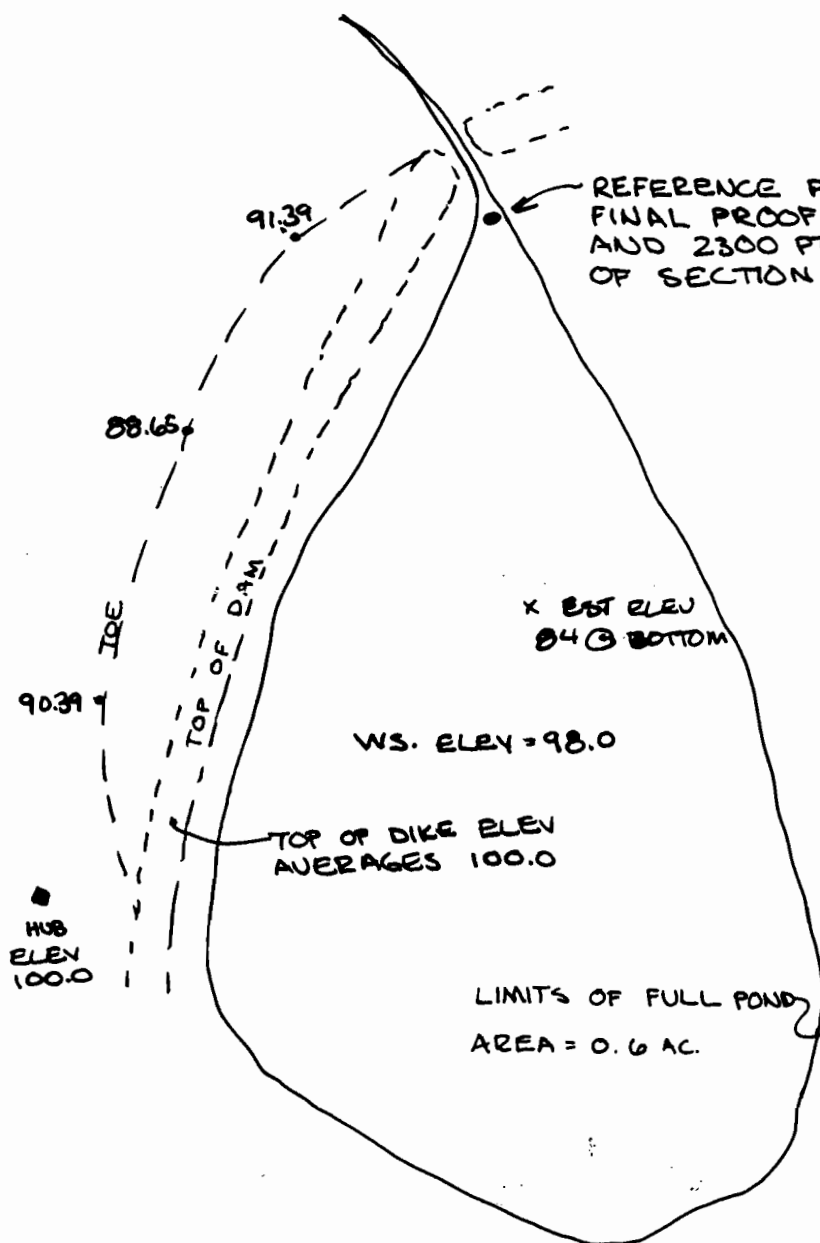

1" = 50'

POND DETAIL MAP TO ACCOMPANY  
TEJAN RANCH FINAL PROOF MAP  
FOR PERMIT # 11379

