


RECORD

MATE
SALVAGE OREGON

FINAL PROOF MAP T26S, R4W, WM

DOUGLAS COUNTY, OREGON
SCALE 1" = 400'

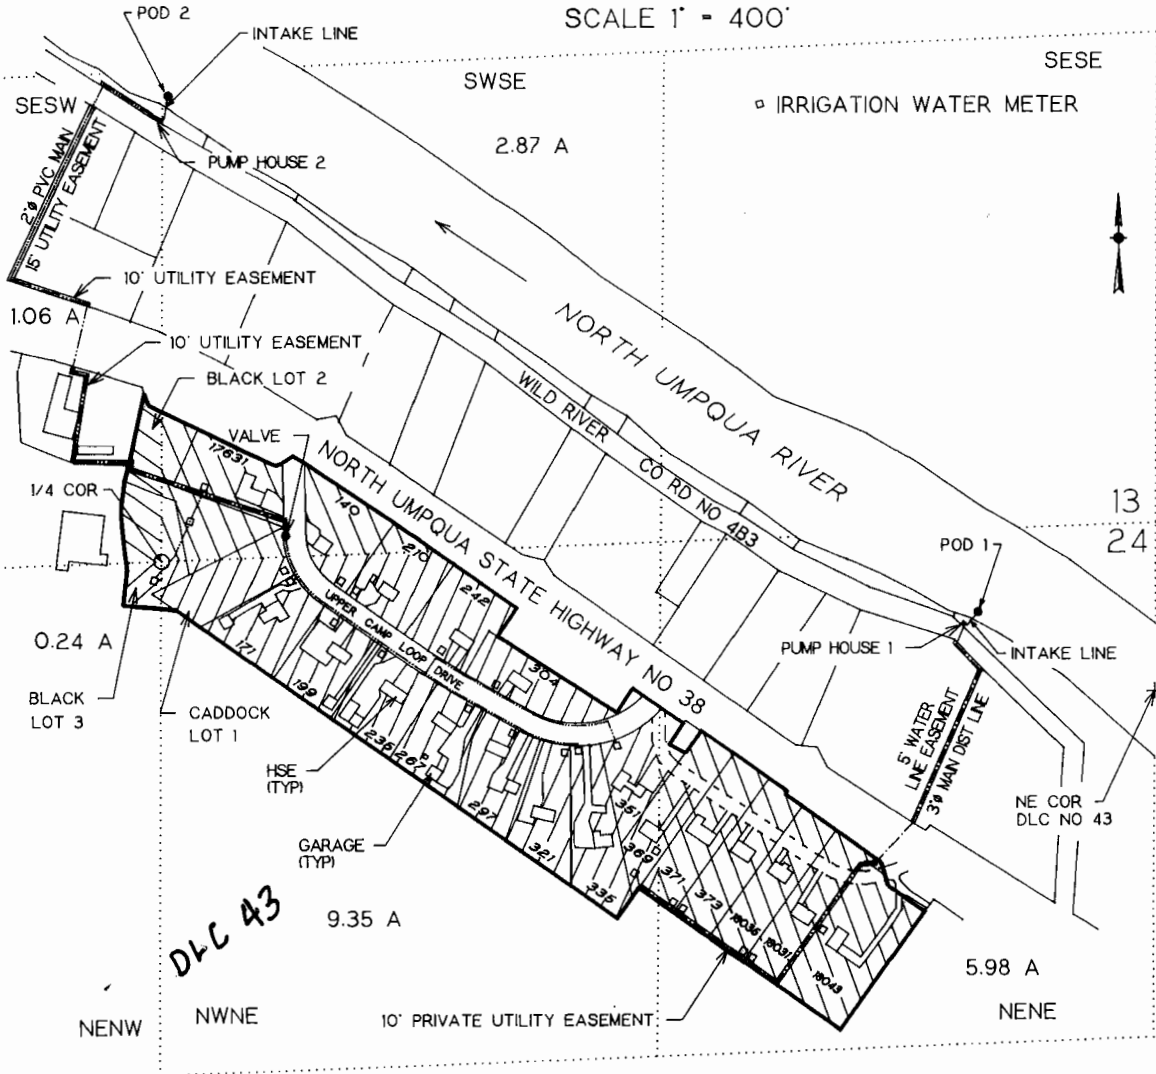

POD 1 IS 240 FT S AND 470 FT W FROM SE COR SEC 13
POD 2 IS 1140 FT N AND 2610 FT W FROM SE COR SEC 13

FINAL PROOF SURVEY

UNDER

Application No. 70835 Permit No. 51263

IN NAME OF

PINE VIEW WATER ASSOCIATION

Surveyed February 1, 1995 by M E Farr

THIS IS A LOCATION MAP FOR A WATER RIGHT FINAL PROOF SURVEY BY PINE VIEW WATER ASSOCIATION. THIS MAP IS FOR THE PURPOSE OF IDENTIFYING THE LOCATION OF THE WATER RIGHT ONLY AND IS NOT INTENDED TO PROVIDE LEGAL DIMENSIONS OR LOCATIONS OF PROPERTY OWNERSHIP LINES.

5/12/08
ADD5 DCC 43 WRD-LNN



EXPIRES 12-31-95