

SECTION 21, T3N R3W WM

WASHINGTON COUNTY, OREGON


RECEIVED

AUG 21 1995
WATER RESOURCES UNIT
SALEM, OREGON




SCALE: 1" = 400'

MAP BASE:
COUNTY
ASSESSORS
MAP & WAC
1994 PHOTO

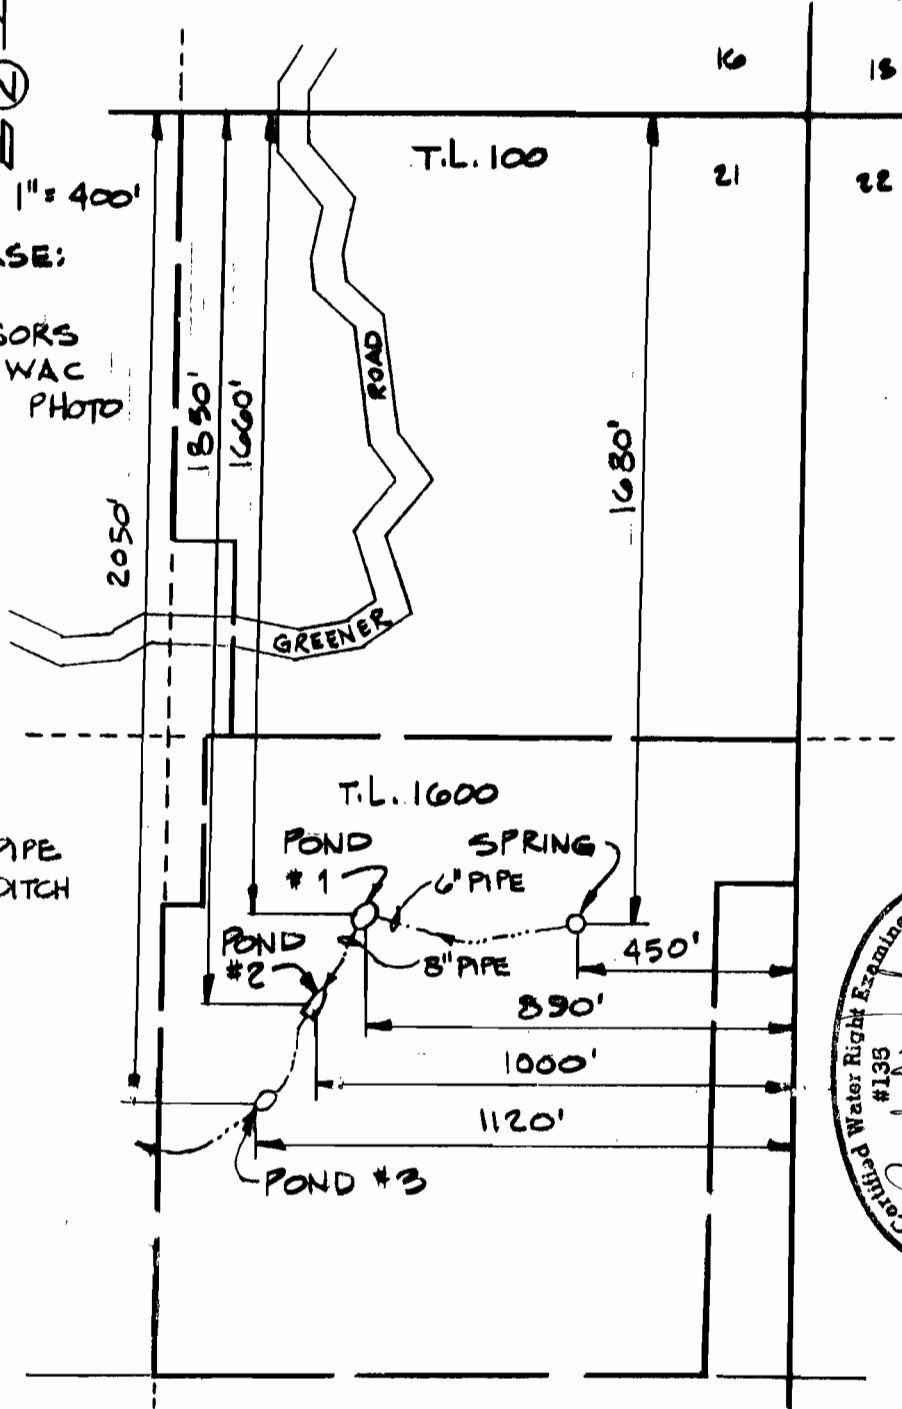

PREPARATION OF THIS MAP IS FOR THE
PURPOSE OF IDENTIFYING THE LOCATION OF
THE WATER RIGHT OF THE STATE OF OREGON
TO PROVIDE DIRECTION TO THE LOCATION OF
PROPERTY OWNERSHIP LINES

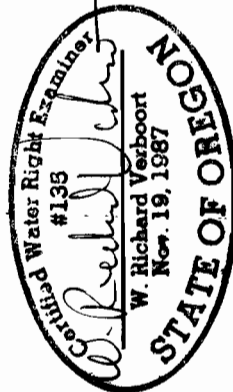

FINAL PROOF SURVEY

UNDER

APPLICATION R-71792 PERMIT R-11464

SURVEYED AUGUST 21, 1995

VERBOORT ENGINEERING
AGRICULTURE • CIVIL • WATER RESOURCES
HILLSBORO, OREGON

designed WRV 8-95
drawn WRV 8-95
checked WRV 8-95
drawing no. 95-A-08
sheet no. 1/1

DAVID & MARY STOCKER
29600 NW GREENER RD
CORNELIUS, OR 97113