


T. 3N., R. 3W., W.M.

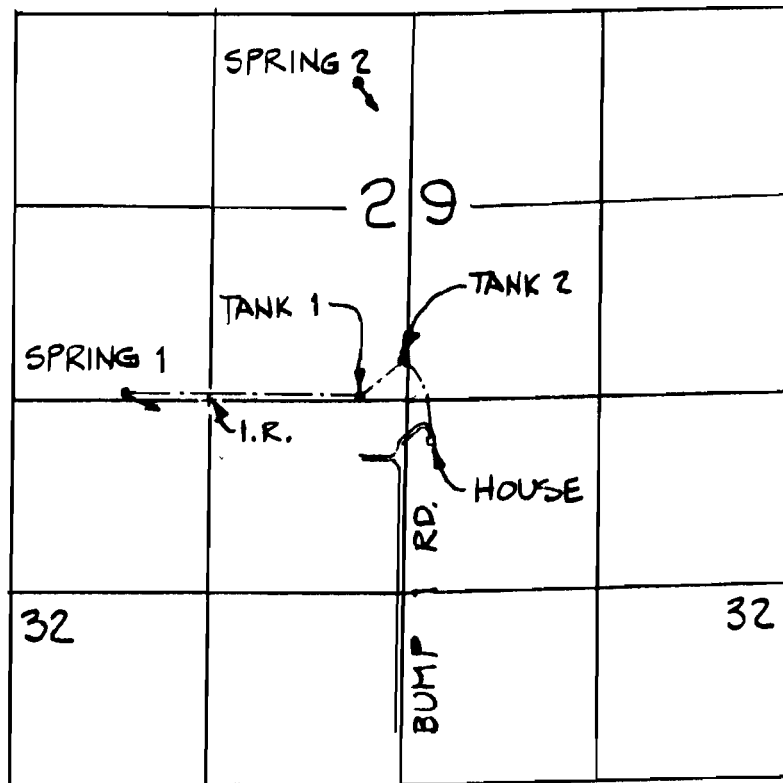

REF.
P-11574
C-12395
AND
P-48460
C-60825
FOR PRIOR
USE DATA



SCALE: 1" = 1320'

--- PIPELINE

SPRING 1 LOC.: 20' N. & 560' W.

SPRING 2 LOC.: 2180' N & 980' E., BOTH FROM SE COR.
NW 1/4, SW 1/4, SEC. 29

MAP BASE:
ODWR PREP
SURVEY
1994 WAC PHOTO

FINAL PROOF SURVEY


SURVEYED AUGUST 18, 1995

APPLICATION - 71350

PERMIT - 51440

RECEIVED

SEP 1995
SALIM

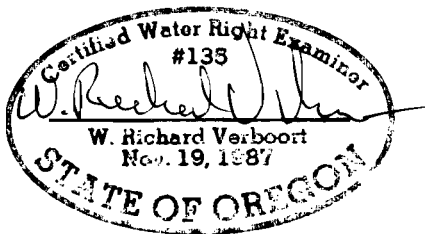

PREPARATION OF THIS MAP IS FOR THE
PURPOSE OF IDENTIFYING THE LOCATION OF
THE WATER RIGHT ONLY. THERE IS NO INTENT
TO PROVIDE DIMENSIONS OR LOCATION OF
PROPERTY OWNERSHIP LINES.

VERBOORT ENGINEERING
AGRICULTURE • CIVIL • WATER RESOURCES
HILLSBORO, OREGON

by date
designed WRY 8/95
drawn JER 8/95
checked _____
drawing no. 95-A-07
sheet no. 1/1

FORREST E. & ROSEMARY BUMP
2011 CEDAR ST.
FOREST GROVE, OR 97116