

RECEIVED


T5N, R29E, W.M.,  
UMATILLA COUNTY, OREGON

**FINAL PROOF SURVEY**

Application No. G-13360  
Permit No. G-11722


IN THE NAME OF:

Christopher J. & Sharon L. Burns  
Route 3, Box 3402 Dallas Road  
Hermiston, Oregon 97838-9715  
Phone No. 503-567-2373

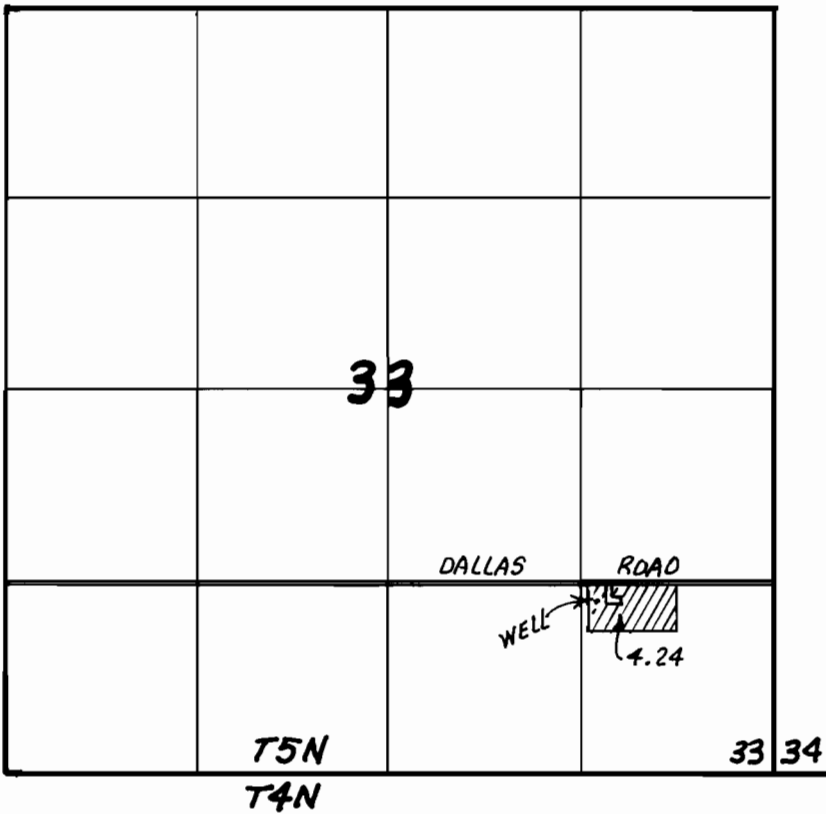

Scale: 1" = 1320'

*This map is for identifying the location of water rights only and is not intended to show property lines or dimensions.*

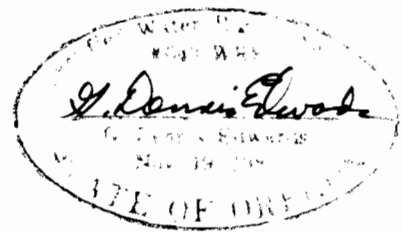

Well lies 1205' North & 1205' West of S.E. Cor. of Section 33.

Edwards Surveying P.O. Box 763  
503-567-3336 Hermiston, OR. 97838  
7/19/95 Job #W9303014-A