
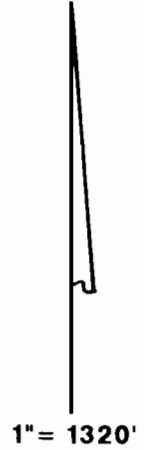


T.7S., R2W., W.M.

RECEIVED

AUG 18 1997

WATER RESOURCES DEPT  
SALEM OREGON

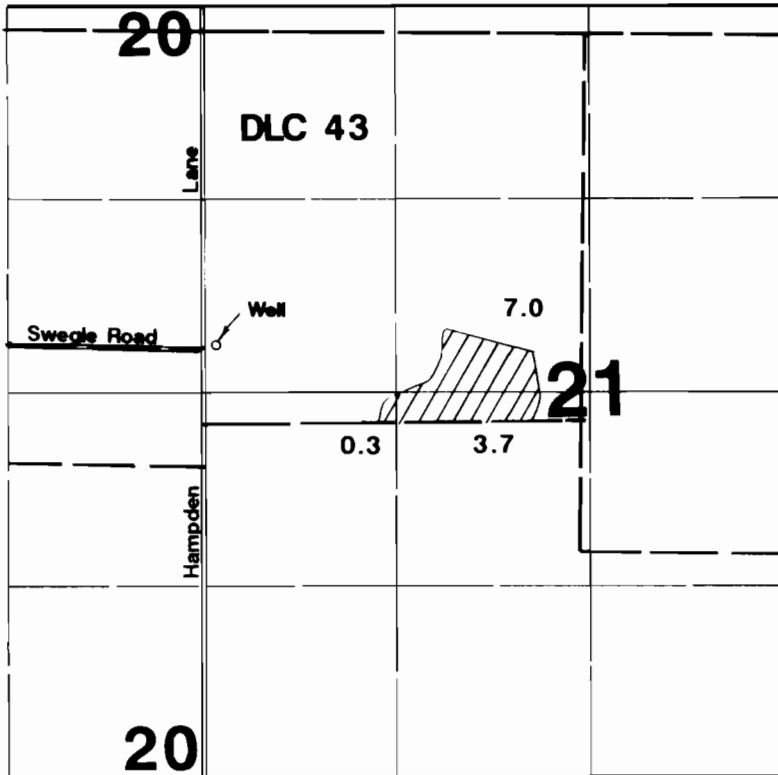

Well located 530'N & 110'E from S'y SW corner DLC 43.

### Final Proof Survey

Application #: G-12519      Permit #: G-11639

In Name Of

## Daniel Haury

Surveyed on August 12, 1997 by JM Schuette

THIS MAP WAS PREPARED FOR THE PURPOSE OF IDENTIFYING THE LOCATION OF A WATER RIGHT ONLY AND IS NOT INTENDED TO PROVIDE LEGAL DIMENSIONS OR LOCATION OF PROPERTY OWNERSHIP LINES.

