



TOWNSHIP 3 SOUTH, RANGE 1 WEST, W.M.

Section 35

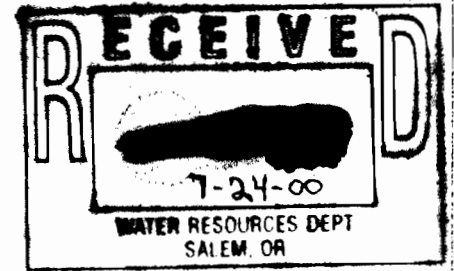

Scale 1" = 400'

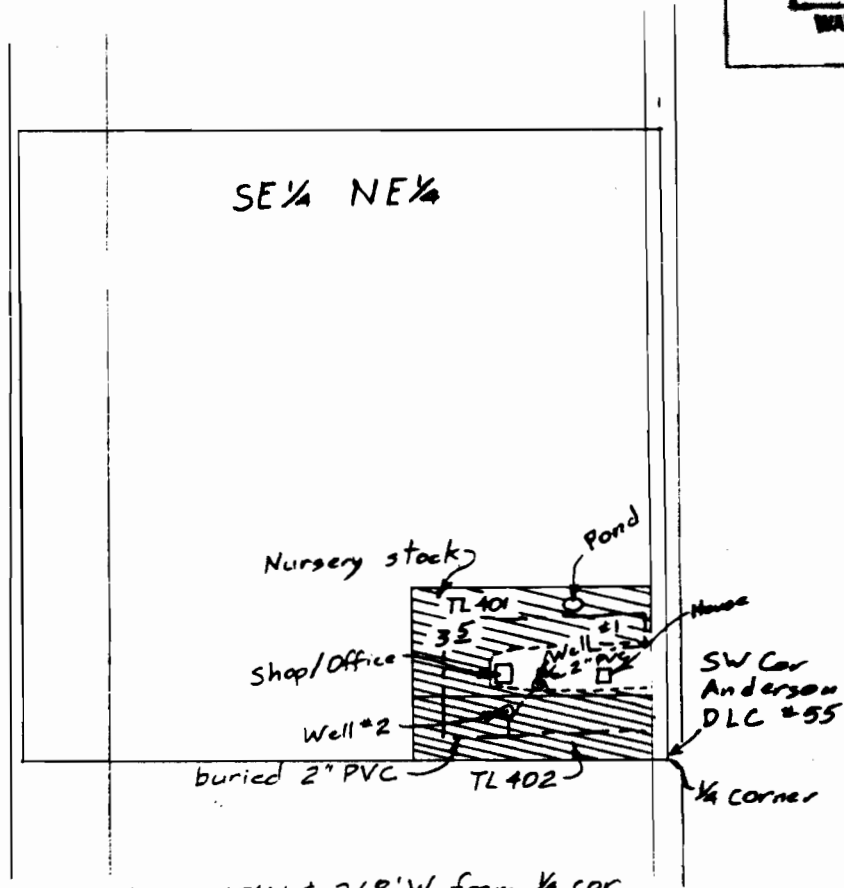

Well #1 - 155' N & 268' W from 1/4 cor.  
Well #2 - 100' N & 330' W from 1/4 cor.

Surveyed March 17, 2000

Claim of Beneficial Use Map  
for

HARLEY & LYNN HIGGINS  
(Sun Landscape Nursery)

Application G-14286 Permit G-13081  
& Application G-14858 Permit G-13672



This map is for the purpose of locating a water right only and has no intent to provide legal dimensions or the location of property lines.

**ESTES SURVEYS**

PO Box 17519 60382 Arnold Rd  
Salem, OR 97305-7519 Bend, OR 97702  
(503) 585-7593 (541) 382-7391