
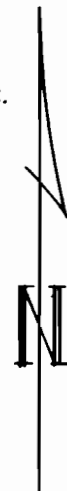


T 26 S, R 28 E, WM

RECEIVED

MAY 20 1996

WATER RESOURCES DEPT.
SALEM, OREGON

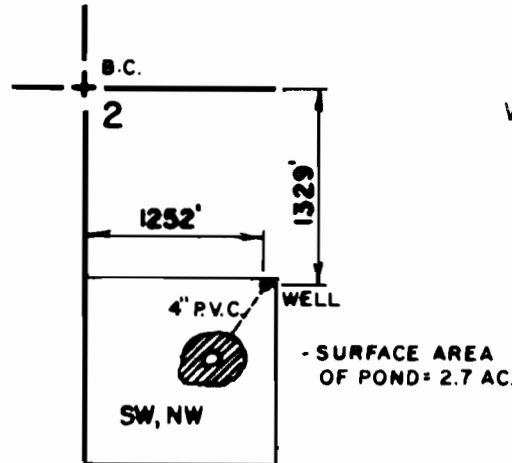

THE PURPOSE OF THIS MAP IS TO
IDENTIFY THE LOCATION OF THE
WATER RIGHT. IT IS NOT INTENDED
TO PROVIDE INFORMATION RELATIVE
TO THE LOCATION OF PROPERTY
OWNERSHIP.

	FINAL PROOF SURVEY		
	UNDER APPLICATION NO. G-12820 PERMIT NO. G-11681		IN THE NAME OF LOUIS AND DORIS YRIARTE
	Scale: 4" = 1 MILE	Date: MAY 1996	Job: 1280-B
	Dsn:	M. A. PALMER & SONS, INC. ENGINEERING & SURVEYING 254 N. Alder - Box 61 Burns, Oregon 97720	Sht. No.
	Drn: CHRIS		of 1
Ckd:			