


**RECEIVED**

JUN 03 1997

WATER RESOURCES DEPT.  
SALEM, OREGON

**T.5S., R.1W., W.M.**

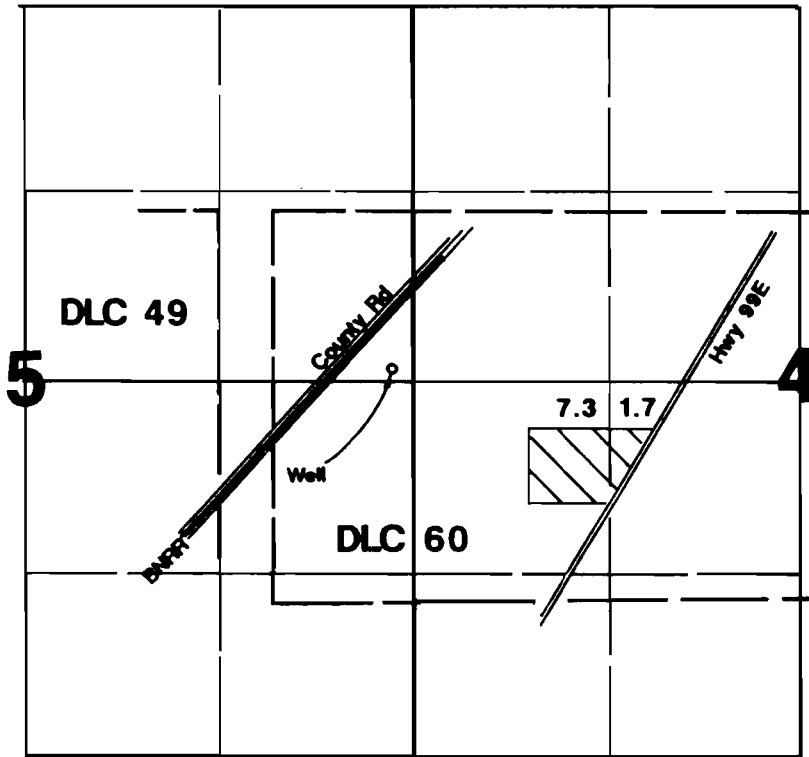

Well located 90'N & 120'W from E $\frac{1}{4}$  corner Section  $\frac{A}{5}$

**Final Proof Survey**

**Application #: G-14072**


**Permit #: G-12874**

In Name Of

**Lucy O'Neal**

Surveyed on May 10, 1997 by JM Schuette

THIS MAP WAS PREPARED FOR THE PURPOSE OF IDENTIFYING THE LOCATION OF A WATER RIGHT ONLY AND IS NOT INTENDED TO PROVIDE LEGAL DIMENSIONS OR LOCATION OF PROPERTY OWNERSHIP LINES.

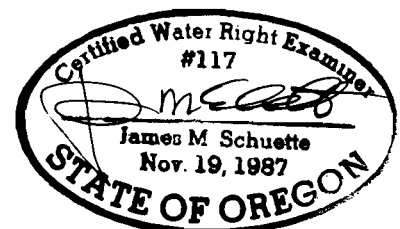

*Map amended by WRD 7-31-08 AC*