
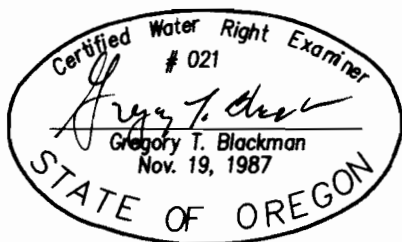


RECEIVED

JAN 26 2001

WATER RESOURCES DEPT.
SALEM, OREGON

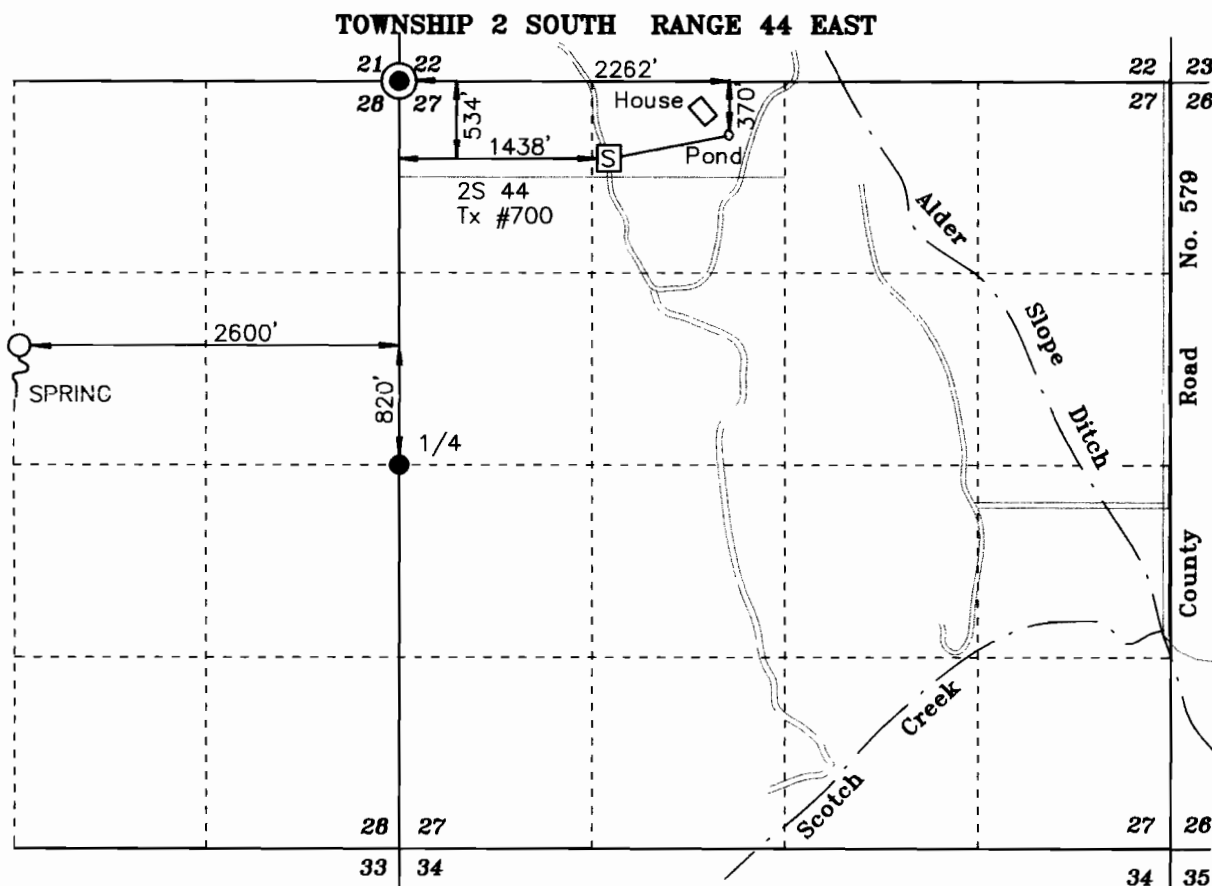

**FINAL PROOF MAP OF
STORAGE POND**

FOR

George S. Gabriel

BY

BAGETT- GRIFFITH & BLACKMAN

2006 ADAMS AVE.

LAGRANDE, ORE. 97850

December 22, 2000

NOTE: The preparation of this map was for the purpose of identifying the location of the proposed water right and has no intent to provide dimensions or location of property ownership lines. Location information shown hereon was furnished by the applicant.

APPLICATION NO. **R- 83531**

PERMIT NO. **R- 12918**