


T. 6S., R. 25E., W.M.


MORROW COUNTY

SCALE 1" = 1320'

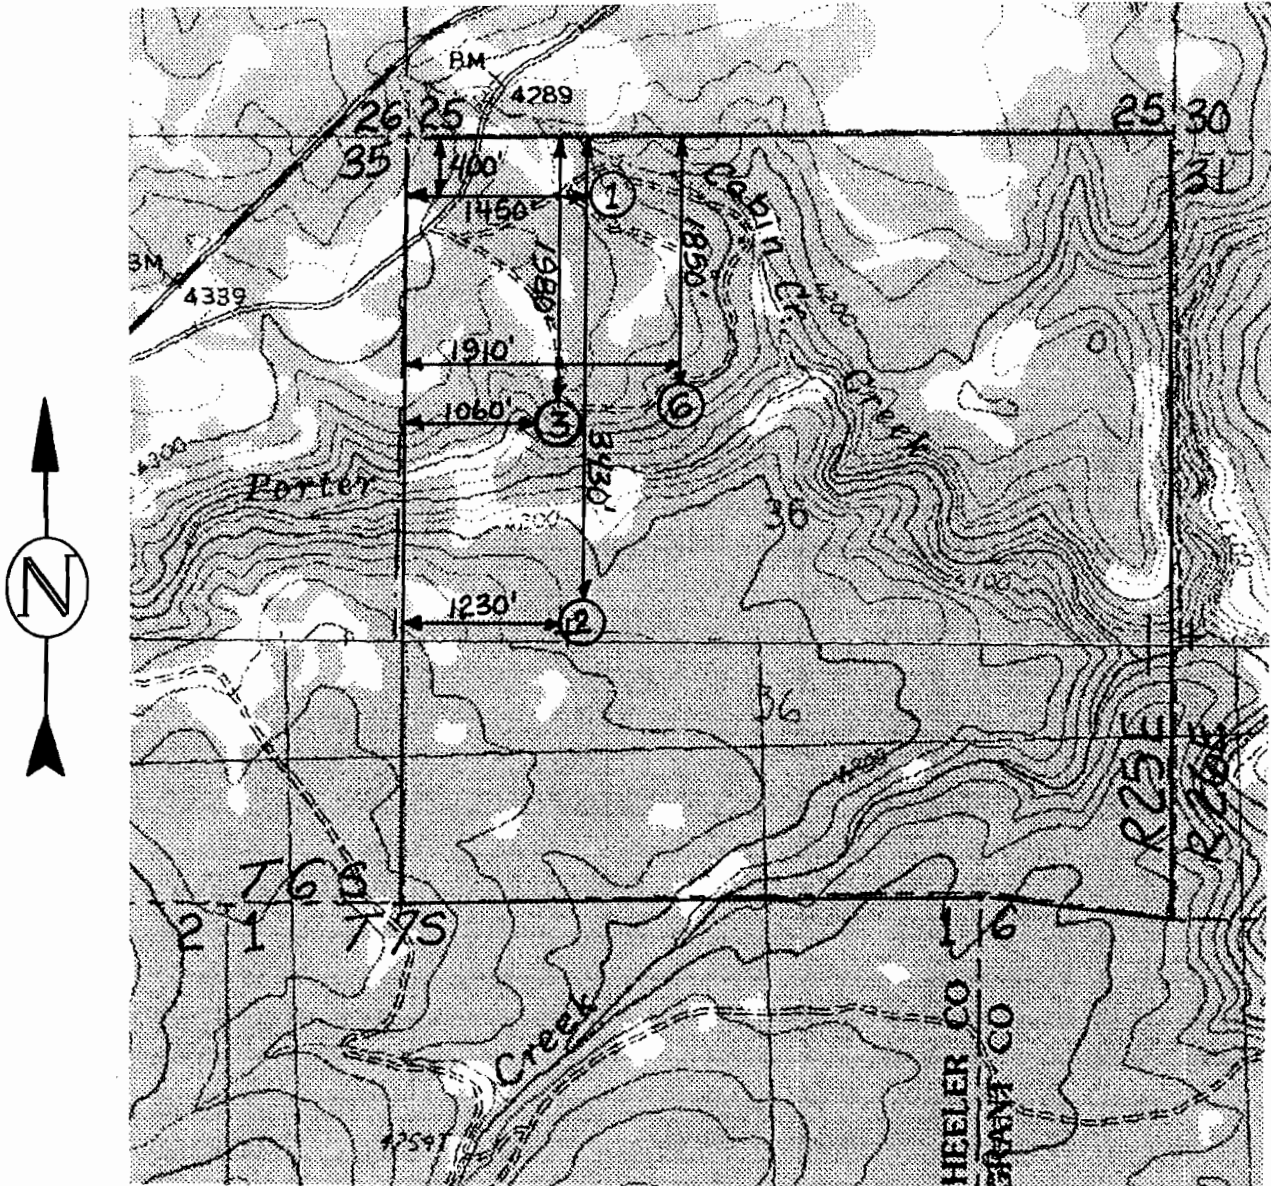

- Spring 1 (P#S-52875) - 400' South & 1450' East of NW Corner
- Spring 2 (P#S-52912) - 3430' South & 1230' East of NW Corner
- Spring 3 (P#S-52873) - 1980' South & 1060' East of NW Corner
- Spring 6 (P#S-52911) - 1850' South & 1910' East of NW Corner
- Res. 1 (P# R-11820)
- Res. 2 (P# R-12071)
- Res. 3 (P# R-12059)
- Res. 6 (P# R-12072)

WATER RIGHTS RROOF MAP
IN NAME OF
LEE PALMER

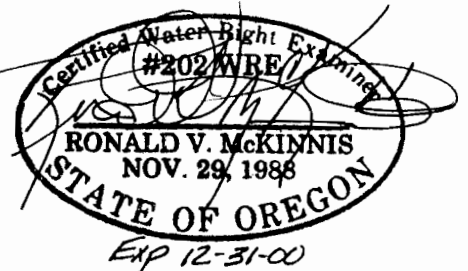

THIS MAP IS FOR THE PURPOSE
OF IDENTIFYING THE LOCATION
OF WATER RIGHTS ONLY AND IS
NOT INTENDED TO PROVIDE THE
LEGAL DIMENSIONS OR LOCATIONS
OF PROPERTY OWNERSHIP LINES.

RECEIVED

AUG 31 2000

WATER RESOURCES DEPT.
SALEM, OREGON

ENGINEERING - LAND SURVEYING - WATER RIGHTS

R. V. McKINNIS ENGINEERING

79980 Prindle Loop Road
Hermiston, Oregon 97838
(541) -567-2017

