

Section 12 Township 26 S Range 13 W W.M.
 Tax Lots 801, 803 & 900
 Coos County

TL 801, 803 & 900

CS 1/16

RECEIVED

DEC - 9 1996

WATER RESOURCES DEPT.
 SALEM, OREGON

1" = 200 Feet

P.O.B.

SURFACE AREA 0.2 ACRE



NOTE:

The P.O.D. is an earthen dam, 54 feet long, 11 foot top width and 9 feet high with a 1 HP pump. The P.O.D. is located 240 feet south and 180 feet east of the CS 1/16 corner of Sec. 12, T.26S, R.13W, W.M.

520' of 3/4" Dia. PVC pipe

100' of 3/4" Dia. PVC pipe

1500 GALLON STORAGE TANK

SHOP

0.5 ac. BARN

RESIDENCE

SE 1/4 SW 1/4

Legend


P.O.B.

P.O.D.

PIPE

STREAM

IRRIGATED AREA

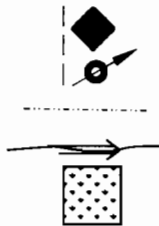


S 1/4

EXAMINERS DISCLAIMER STATEMENT

NOTE:

The P.O.D. and Waterline is entirely located on property owned by the applicant.

The preparation of this map was for the purpose of identifying the location of the Water Right only and has no intent to provide dimensions or location of property ownership lines.

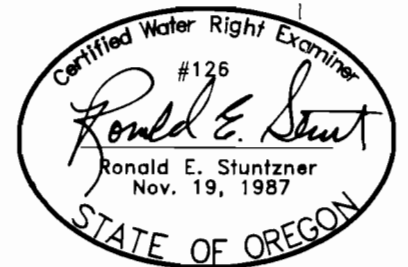

EXPIRES 06/30/98

FINAL PROOF SURVEY

Prepared For: Nick & Joyce Jansen
 Prepared By: Dennis Goude
 Surveyed: June 10, 1994

Application No. R-74436 & S-74437
 Permit No. R-11759 & 52129