


RECEIVED
OCT 03 2001
WATER RESOURCES DIVISION

CLAIM OF BENEFICIAL USE MAP

UNDER APPLICATION R-82513; PERMIT R-12270

SE1/4 NE1/4 SEC 27 T 19S R 40E W.M.

U.S.G.S. QUAD - LITTLE BLACK CANYON, OREG. - 7 1/2'

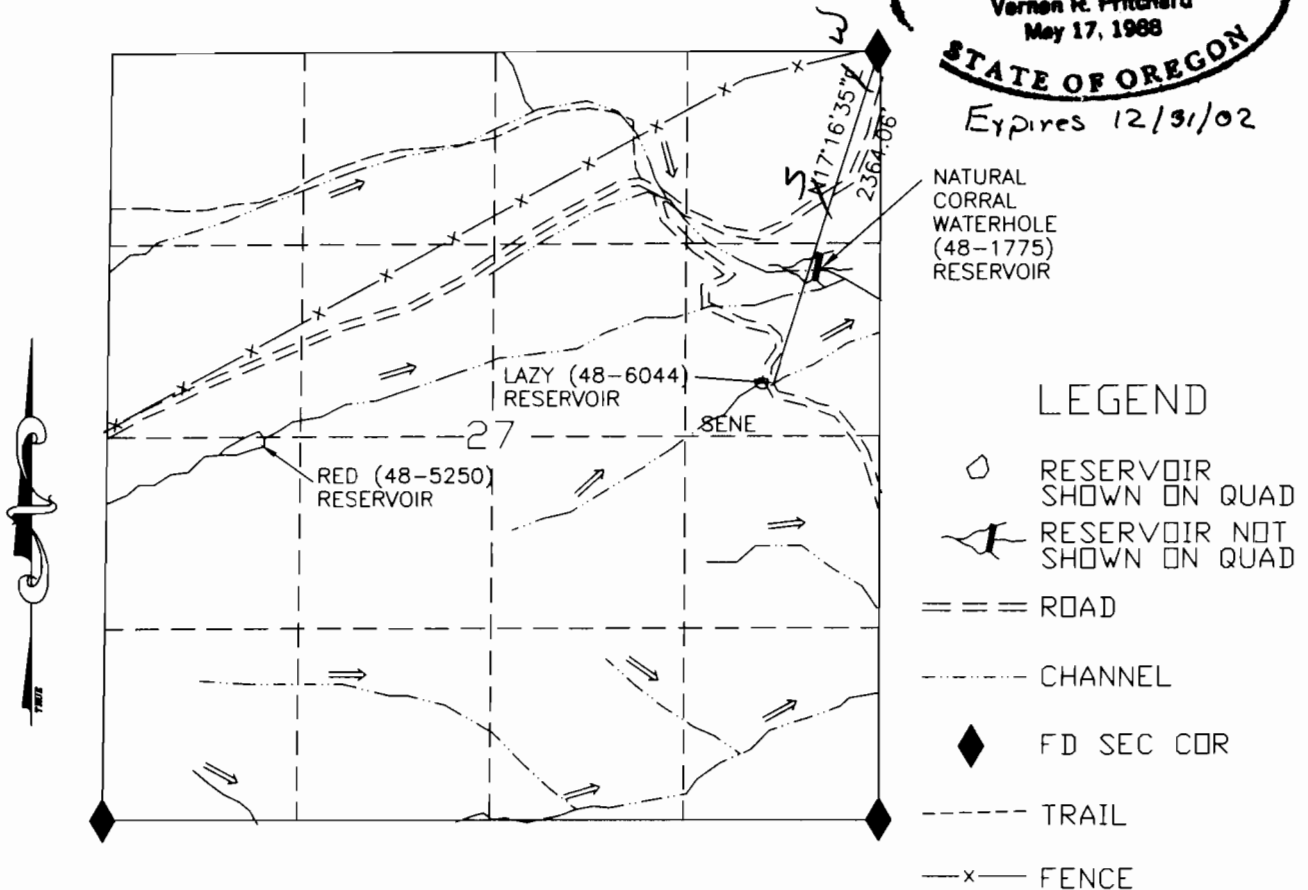

LAZY (48-6044) RESERVOIR

Map amended by WRO staff 8-15-2008

1320 660 0 1320
SCALE 1"=1320'

I, Jerry Eastman, Acting ADM Operations/Field Services agree to the findings of the CWRE and do submit this site report and map as my Claim of Beneficial Use of the water as provided under the terms and conditions of my Permit R-82513.



THIS MAP IS FOR THE PURPOSE OF LOCATING A WATER RIGHT AND IS NOT INTENDED TO PROVIDE LEGAL DIMENSIONS FOR LOCATION OF PROPERTY BOUNDARIES.

ACAD14
DWG FILE: LAZYBEN

UNITED STATES DEPARTMENT OF THE INTERIOR
BUREAU OF LAND MANAGEMENT
DIVISION OF OPERATIONS VALE DISTRICT

LAZY (48-6044) RESERVOIR

DRAWN BY: Vernon R. Pritchard
SURVEYED: Vernon R. Pritchard
APPROVED: Jerry Eastman
ADM OPERATIONS AND FIELD SERVICES
DRAWN: CG SCALE: 1"=1320'
DATE: 11/02/00 SHEET 1 OF 1
DRAWING NO. OR-03-9172.45-1085