


CLAIM OF BENEFICIAL USE MAP


UNDER APPLICATION R-82526; PERMIT R-12281

NE1/4 SE1/4 SEC 15 T 36S R 43E W.M.

U.S.G.S. QUAD - BATTLE CREEK RANCH, OREG. - 7 1/2'

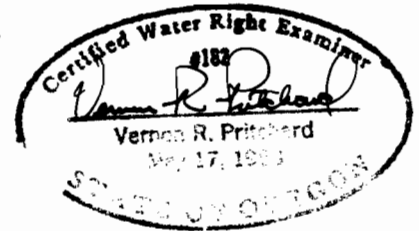

Expires 12/31/02

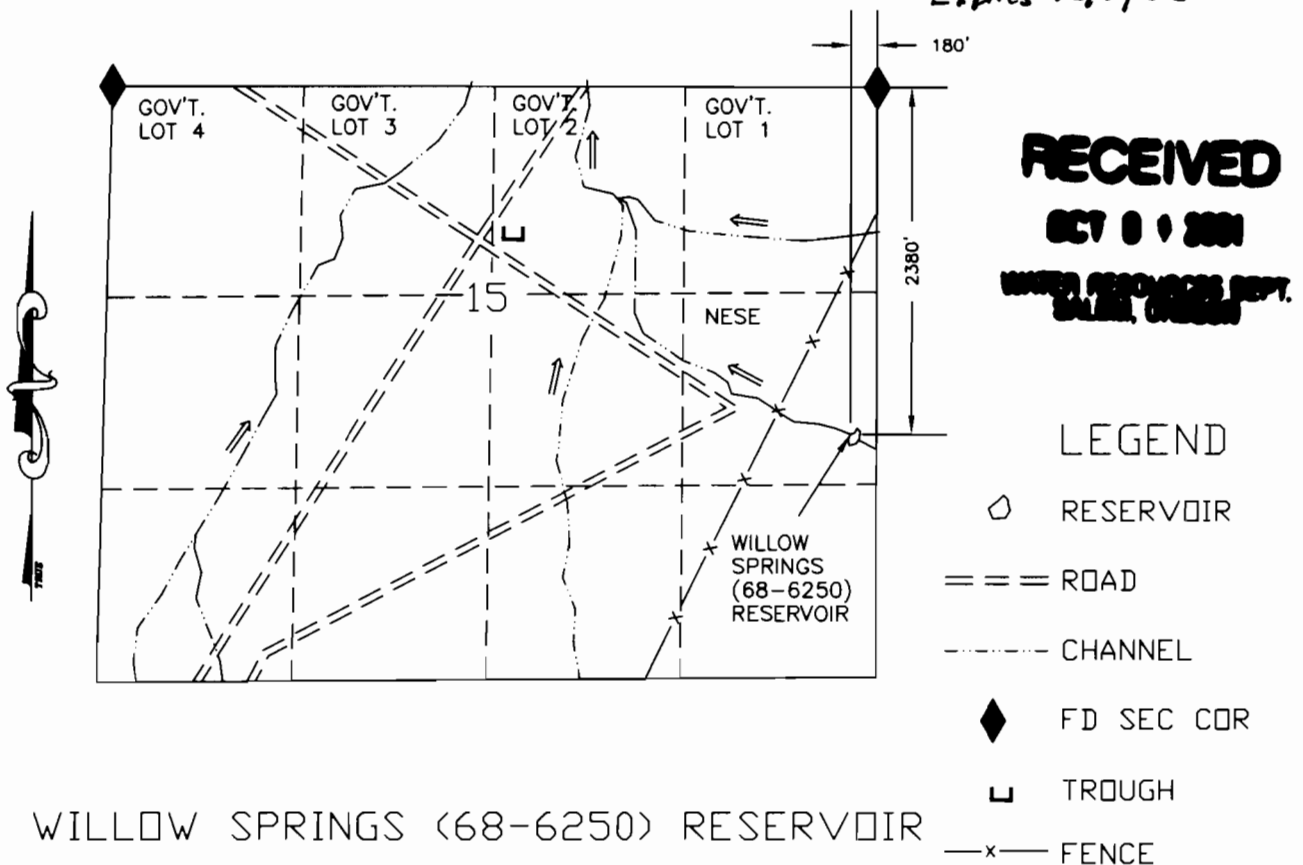

WILLOW SPRINGS (68-6250) RESERVOIR

1320 660 0 1320
SCALE 1"=1320'

I, Vernon R. Pritchard, Acting ADM Operations/Field Services agree to the findings of the CWRE and do submit this site report and map as my Claim of Beneficial Use of the water as provided under the terms and conditions of my Permit R-82526.



THIS MAP IS FOR THE PURPOSE OF LOCATING A WATER RIGHT AND IS NOT INTENDED TO PROVIDE LEGAL DIMENSIONS FOR LOCATION OF PROPERTY BOUNDARIES.

ACAD14
DWG FILEWILLOWSBEN

UNITED STATES DEPARTMENT OF THE INTERIOR BUREAU OF LAND MANAGEMENT DIVISION OF OPERATIONS VALE DISTRICT	
WILLOW SPRINGS (68-6250) RESERVOIR	
DRAWN:	CG
DATE:	11/08/00
DRAWING NO.	OR-03-9172.45-1095
SCALE:	1"=1320'
SHEET	1 OF 1