


CLAIM OF BENEFICIAL USE MAP

UNDER APPLICATION R-82525; PERMIT R-12280

NE1/4 SW1/4 SEC 16 T 37S R 41E W.M.

U.S.G.S. QUAD - BLUE MOUNTAIN BASIN, OREG. - 7 1/2'

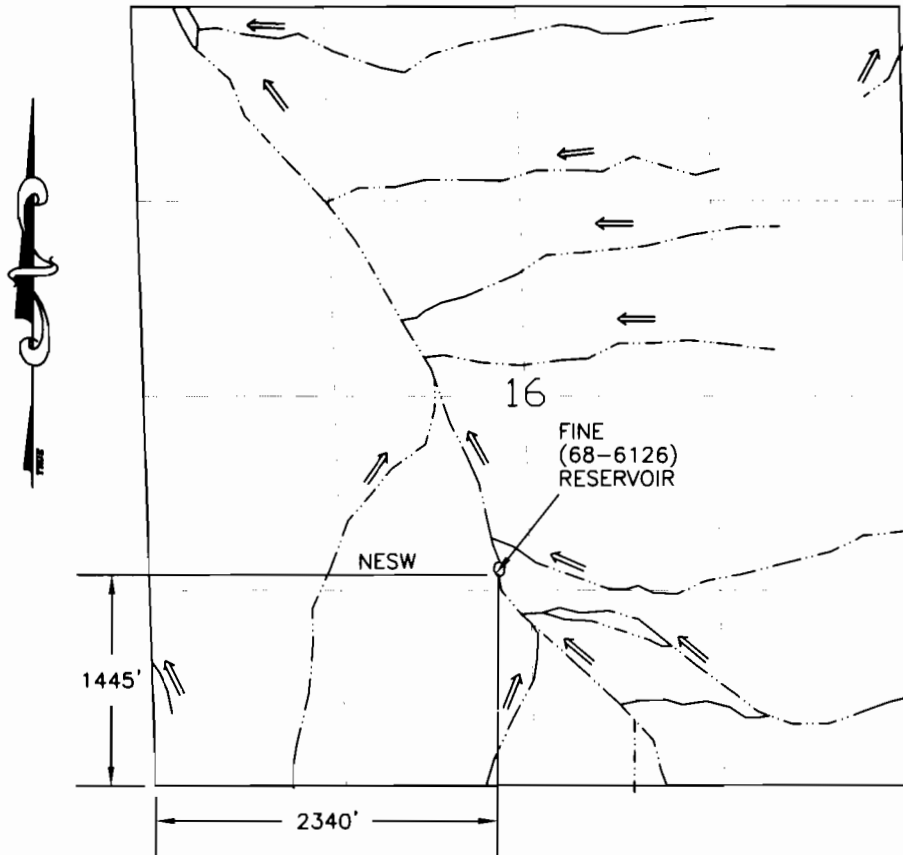


LEGEND

- RESERVOIR SHOWN ON QUAD
- CHANNEL

RECEIVED


OCT 03 2001

STATE OF OREGON

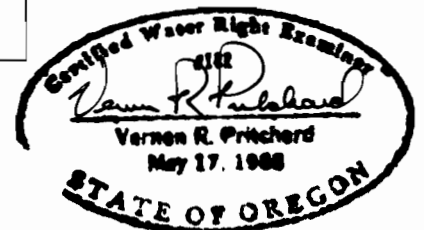

Expires 12/31/02


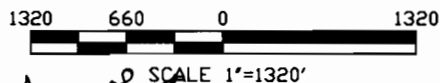

[Signature]
Acting ADM Operations/Field Services
agree to the findings of the CWRE and do submit
this site report and map as my Claim of Beneficial
Use of the water as provided under the terms and
conditions of my Permit R-12280.

THIS MAP IS FOR THE PURPOSE OF LOCATING
A WATER RIGHT AND IS NOT INTENDED TO
PROVIDE LEGAL DIMENSIONS FOR LOCATION
OF PROPERTY BOUNDARIES.



ACAD14
DWG FILE: FINEBEN

UNITED STATES DEPARTMENT OF THE INTERIOR
BUREAU OF LAND MANAGEMENT
DIVISION OF OPERATIONS VALE DISTRICT

FINE (68-6126)
RESERVOIR

DRAWN BY:

SURVEYED:

APPROVED

DRAWN:

DATE:

DRAWING NO.

CG

11/02/00

OR-03-9172.45-1079

SCALE: 1"=1320'

SHEET 1 OF 1