


CLAIM OF BENEFICIAL USE MAP

UNDER APPLICATION R-82514; PERMIT R-12271

SW1/4 SW1/4 SEC 22 T 21S R 41E W.M.


U.S.G.S. QUAD - AVERY CREEK, OREG. - 7 1/2'

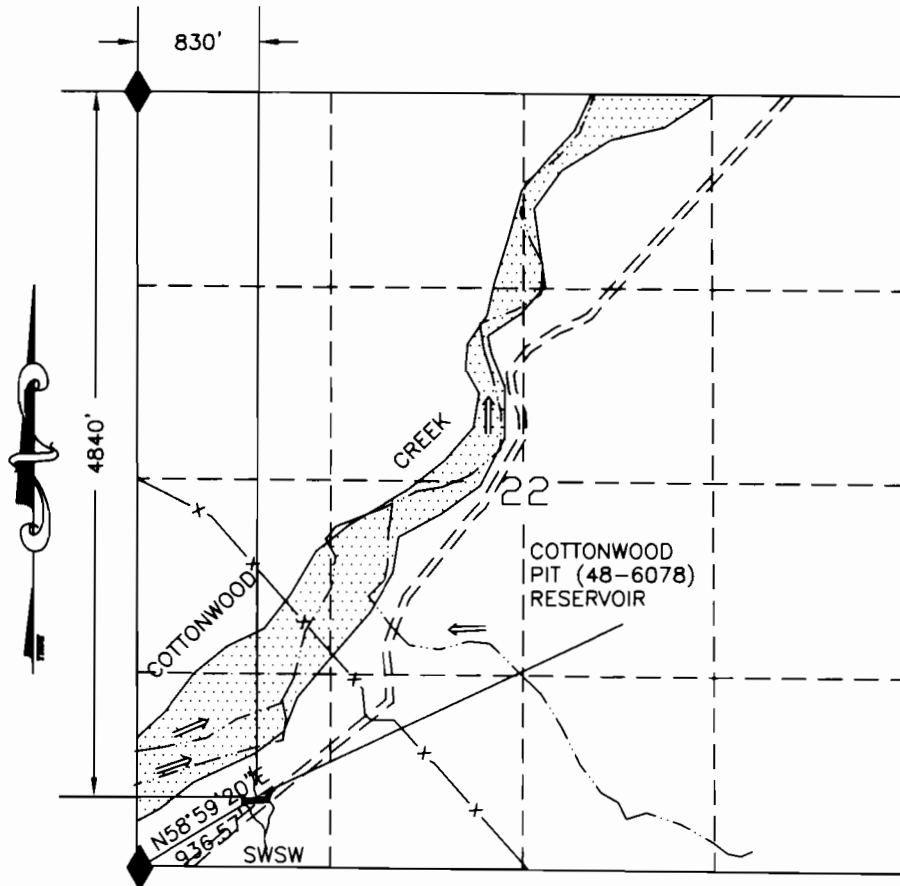

RECEIVED
DEC 03 2001
WATER RIGHTS


LEGEND

- RESERVOIR
- ROAD
- CHANNEL
- FD SEC COR
- FENCE
- DRY RIVER BED

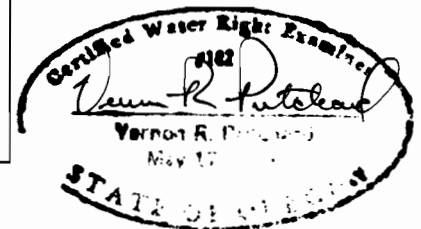

Expires 12/31/02

COTTONWOOD PIT (48-6078) RESERVOIR

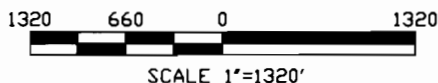

I, Vernon R. Putchak, Acting ADM Operations/Field Services agree to the findings of the CWRE and do submit this site report and map as my Claim of Beneficial Use of the water as provided under the terms and conditions of my Permit R-12271.



THIS MAP IS FOR THE PURPOSE OF LOCATING A WATER RIGHT AND IS NOT INTENDED TO PROVIDE LEGAL DIMENSIONS FOR LOCATION OF PROPERTY BOUNDARIES.

ACAD14
 DWG FILE: COTTONWPBEN

UNITED STATES DEPARTMENT OF THE INTERIOR BUREAU OF LAND MANAGEMENT DIVISION OF OPERATIONS VALE DISTRICT	
COTTONWOOD PIT (48-6078) RESERVOIR	
DRAWN BY: <u>Vernon R. Putchak</u>	
SURVEYED: <u>Vernon R. Putchak</u>	
APPROVED: <u>Vernon R. Putchak</u> ADM OPERATIONS AND FIELD SERVICES	
DRAWN: <u>CG</u>	SCALE: 1"=1320'
DATE: <u>11/02/00</u>	SHEET 1 OF 1
DRAWING NO. <u>OR-03-9172.45-1077</u>	