

CLAIM OF BENEFICIAL USE MAP

UNDER APPLICATION R-82512; PERMIT R-12269

NW1/4 SE1/4 SEC 14 T 25S R 37E W.M.

U.S.G.S. QUAD - MCEWEN BUTTE, OREG. - 7 1/2'

RECEIVED

AUG 16 2002


WATER RESOURCES DEPT
SALEM, OREGON

LEGEND


○ RESERVOIR

== ROAD

- - - CHANNEL

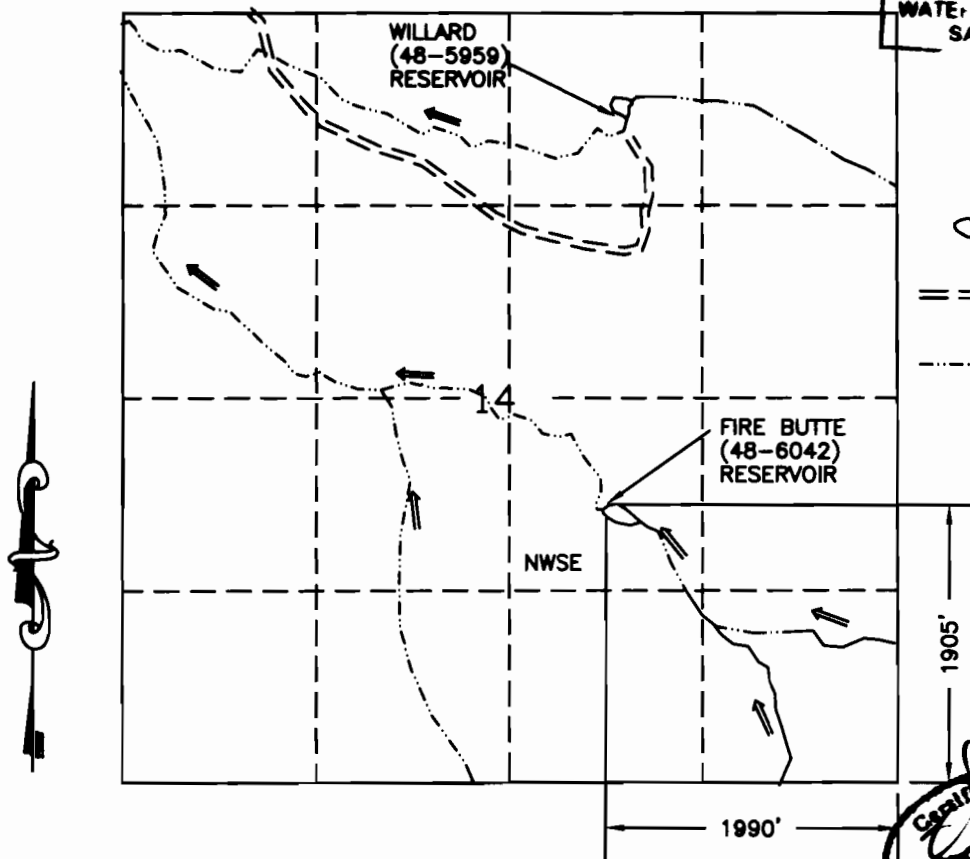

FIRE BUTTE (48-6042) RESERVOIR

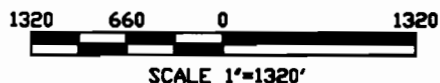

I, Thomas Terry, ADM Operations/Field Services agree to the findings of the CWRE and do submit this site report and map as my Claim of Beneficial Use of the water as provided under the terms and conditions of my Permit R-12269.

Thomas Terry



THIS MAP IS FOR THE PURPOSE OF LOCATING A WATER RIGHT AND IS NOT INTENDED TO PROVIDE LEGAL DIMENSIONS FOR LOCATION OF PROPERTY BOUNDARIES.

ACAD2000/LDD
DWG FILE: FIREBUT.DWG

UNITED STATES DEPARTMENT OF THE INTERIOR
BUREAU OF LAND MANAGEMENT
DIVISION OF OPERATIONS VALE DISTRICT

FIRE BUTTE
(48-6042) RESERVOIR

DRAWN BY:

SURVEYED:

APPROVED

ADM OPERATIONS AND FIELD SERVICES

DRAWN:

CG

SCALE: 1"=1320'

DATE:

11/01/01

SHEET 1 OF 1

DRAWING NO.

OR-03-9172.45-1080