


CLAIM OF BENEFICIAL USE MAP

UNDER APPLICATION R-82511; PERMIT R-12268

SE1/4 NW1/4 SEC 34 T 24S R 39E W.M.

U.S.G.S. QUAD - STAR CREEK RESERVOIR, OREG. - 7 1/2'

RECEIVED
SEP 11 1988
WATER RESOURCES DIV.

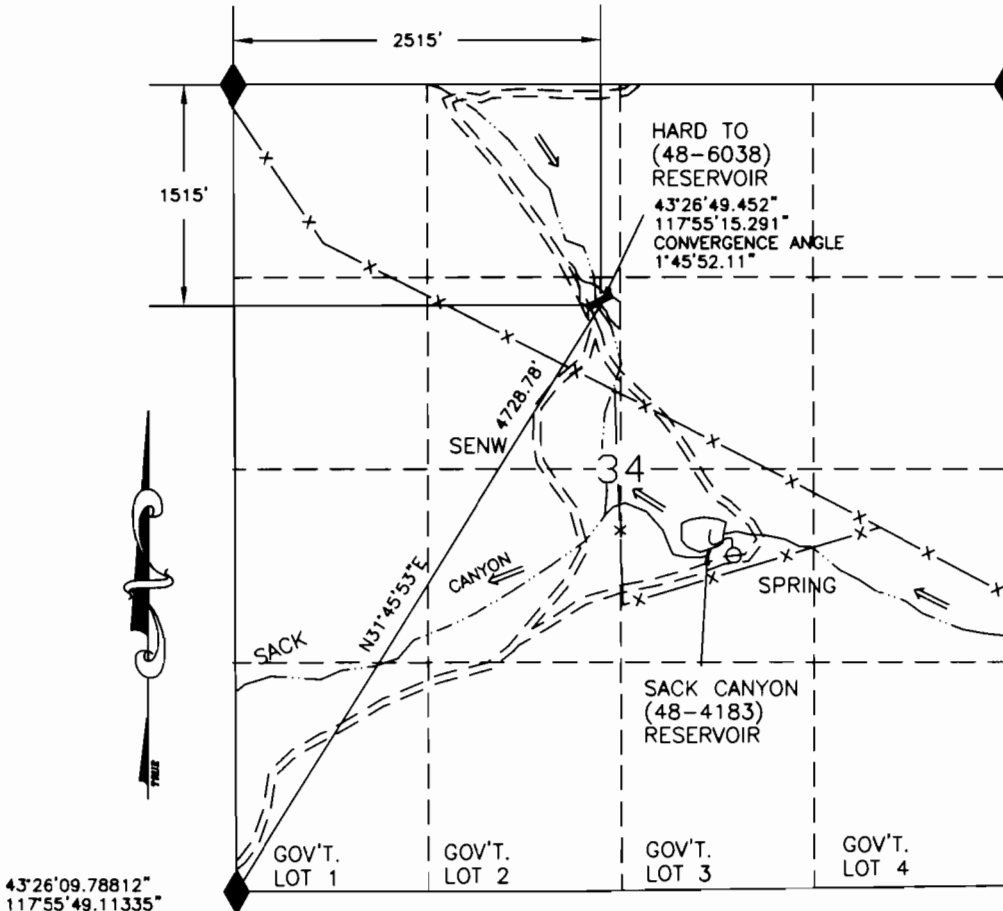

LEGEND

- RESERVOIR SHOWN ON QUAD
- RESERVOIR NOT SHOWN ON QUAD
- ROAD
- CHANNEL
- FD SEC COR
- SPRING
- FENCE

HARD TO (48-6038) RESERVOIR



1320 660 0 1320

SCALE 1"=1320'

Jerry E. Smith
Acting ADM Operations/Field Services
agree to the findings of the CWRE and do submit
this site report and map as my Claim of Beneficial
Use of the water as provided under the terms and
conditions of my Permit R-12268



THIS MAP IS FOR THE PURPOSE OF LOCATING
A WATER RIGHT AND IS NOT INTENDED TO
PROVIDE LEGAL DIMENSIONS FOR LOCATION
OF PROPERTY BOUNDARIES.

ACAD14
DWG FILE: HARDTOBEN

UNITED STATES DEPARTMENT OF THE INTERIOR
BUREAU OF LAND MANAGEMENT
DIVISION OF OPERATIONS VALE DISTRICT

HARD TO (48-6038)
RESERVOIR

DRAWN BY: *Vernon R. Pritchard*
SURVEYED: *Vernon R. Pritchard*
APPROVED: *Jerry E. Smith*

DRAWN: CG SCALE: 1"=1320'

DATE: 11/02/00 SHEET 1 OF 1

DRAWING NO. OR-03-9172.45-1082