


CLAIM OF BENEFICIAL USE MAP

UNDER APPLICATION R-82503; PERMIT R-12260

SE1/4 SE1/4 SEC 11 T 24S R 43E W.M.

U.S.G.S. QUAD - QUARTZ MTN. BASIN, OREG. - 7 1/2'

RECEIVED
SEP 03 2008
WATER DIVISION

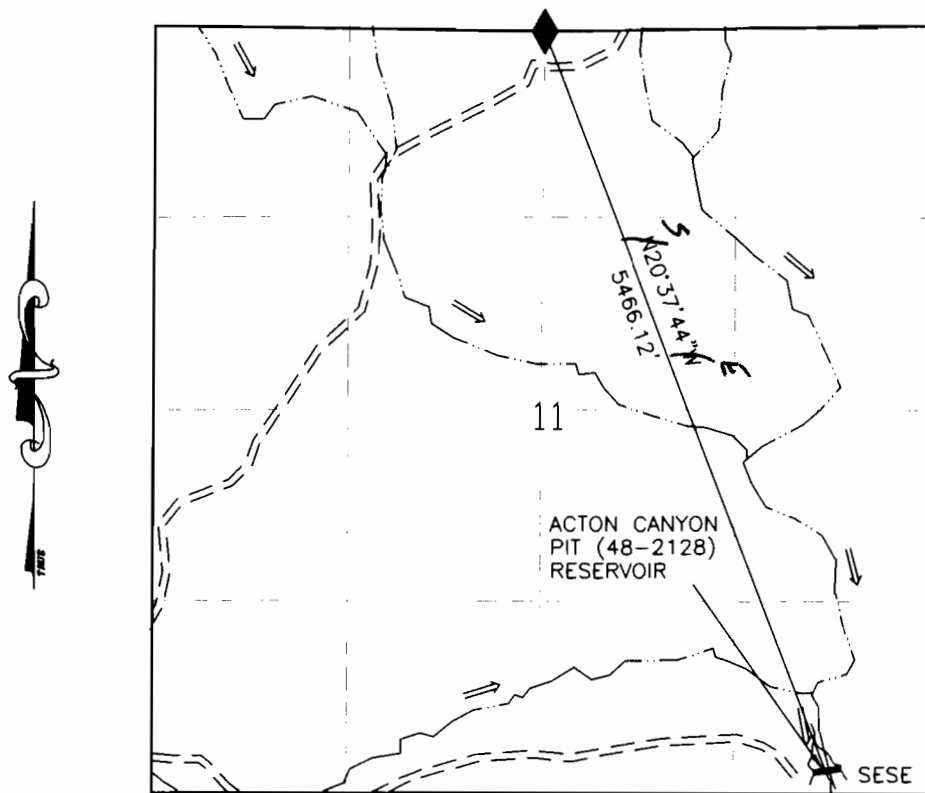

LEGEND
RESERVOIR
ROAD
CHANNEL
FD SEC COR

Certified Water Right
Vernon R. Pritchard
Vernon R. Pritchard
May 17, 1988
STATE OF OREGON
Expires 12/31/02

ACTON CANYON PIT (48-2128) RESERVOIR

Map amended by WRO Staff, 8-15-2008, *WRO*

1320 660 0 1320
SCALE 1"=1320'

I, *[Signature]*, Acting ADM Operations/Field Services agree to the findings of the CWRE and do submit this site report and map as my Claim of Beneficial Use of the water as provided under the terms and conditions of my Permit R-12260.

THIS MAP IS FOR THE PURPOSE OF LOCATING A WATER RIGHT AND IS NOT INTENDED TO PROVIDE LEGAL DIMENSIONS FOR LOCATION OF PROPERTY BOUNDARIES.

**ALWAYS
THINK
SAFETY**

ACAD14
DWG FILE: CTNOCBEN.DWG

UNITED STATES DEPARTMENT OF THE INTERIOR
BUREAU OF LAND MANAGEMENT
DIVISION OF OPERATIONS VALE DISTRICT

ACTON CANYON PIT
(48-2128)

DRAWN BY: *[Signature]*
SURVEYED: *[Signature]*
APPROVED: *[Signature]*
ADM OPERATIONS AND FIELD SERVICES
DRAWN: CG SCALE: 1"=1320'
DATE: 11/02/00 SHEET 1 OF 1
DRAWING NO. OR-03-9172.45-1071