


CLAIM OF BENEFICIAL USE MAP

UNDER APPLICATION R-82508 ; PERMIT R-12265

NE1/4 SE1/4 SEC 1 T 28S R 44E W.M.

U.S.G.S. QUAD - MCCAIN CREEK, OREG. - 7 1/2'

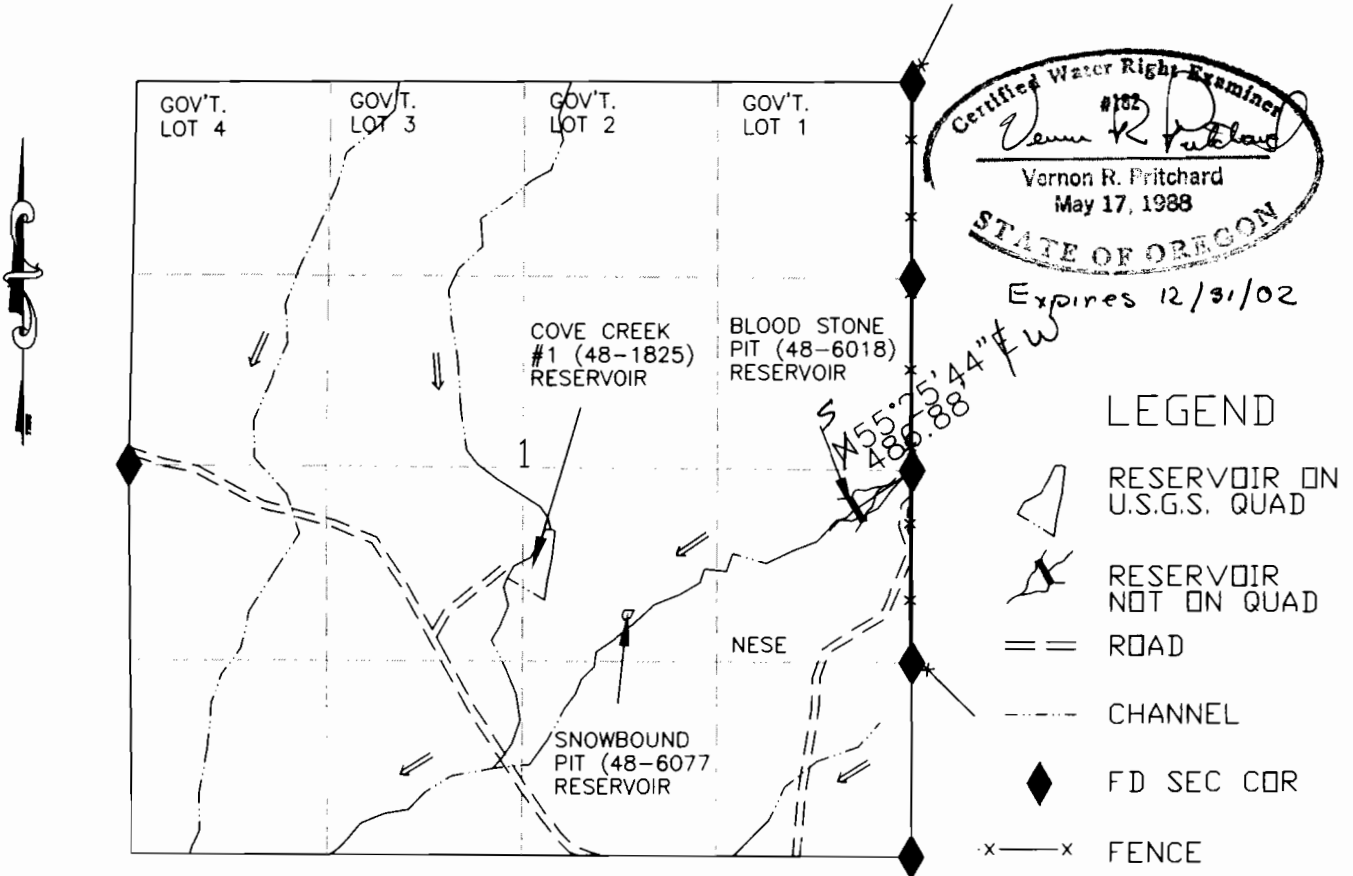

Certified Water Right Examiner
 #182
Vernon R. Pritchard
 Vernon R. Pritchard
 May 17, 1988
 STATE OF OREGON
 Expires 12/31/02

LEGEND

- RESERVOIR ON U.S.G.S. QUAD
- RESERVOIR NOT ON QUAD
- ROAD
- CHANNEL
- FD SEC COR
- FENCE


RECEIVED

OCT 6 1 2001

WATER RESOURCES DEPT.
 SALEM, OREGON

BLOOD STONE PIT (48-6018) RESERVOIR

Map unmounted by Wild Staff, 8-15-2008, jwg

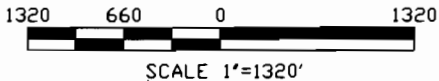

I, *[Signature]* Acting ADM Operations/Field Services agree to the findings of the CWRE and do submit this site report and map as my Claim of Beneficial Use of the water as provided under the terms and conditions of my Permit R-12265



THIS MAP IS FOR THE PURPOSE OF LOCATING A WATER RIGHT AND IS NOT INTENDED TO PROVIDE LEGAL DIMENSIONS FOR LOCATION OF PROPERTY BOUNDARIES.

ACAD14
 DWG FILE: BLOODSBEN.DWG

UNITED STATES DEPARTMENT OF THE INTERIOR
 BUREAU OF LAND MANAGEMENT
 DIVISION OF OPERATIONS VALE DISTRICT

BLOOD STONE PIT (48-6018) RESERVOIR

DRAWN BY: *[Signature]*
 SURVEYED: *[Signature]*
 APPROVED: *[Signature]*
ADM OPERATIONS AND FIELD SERVICES
 DRAWN: CG SCALE: 1"=1320'
 DATE: 11/02/00 SHEET 1 OF 1
 DRAWING NO. OR-03-9172.45-1072