


12874  
9171

MAP  
to accompany application  
of FRANK SMITH  
for a permit to appropriate water  
Sec 25, Twp 26. S. R. 13 W.  
Coos County Ore.

D. L. Buckingham

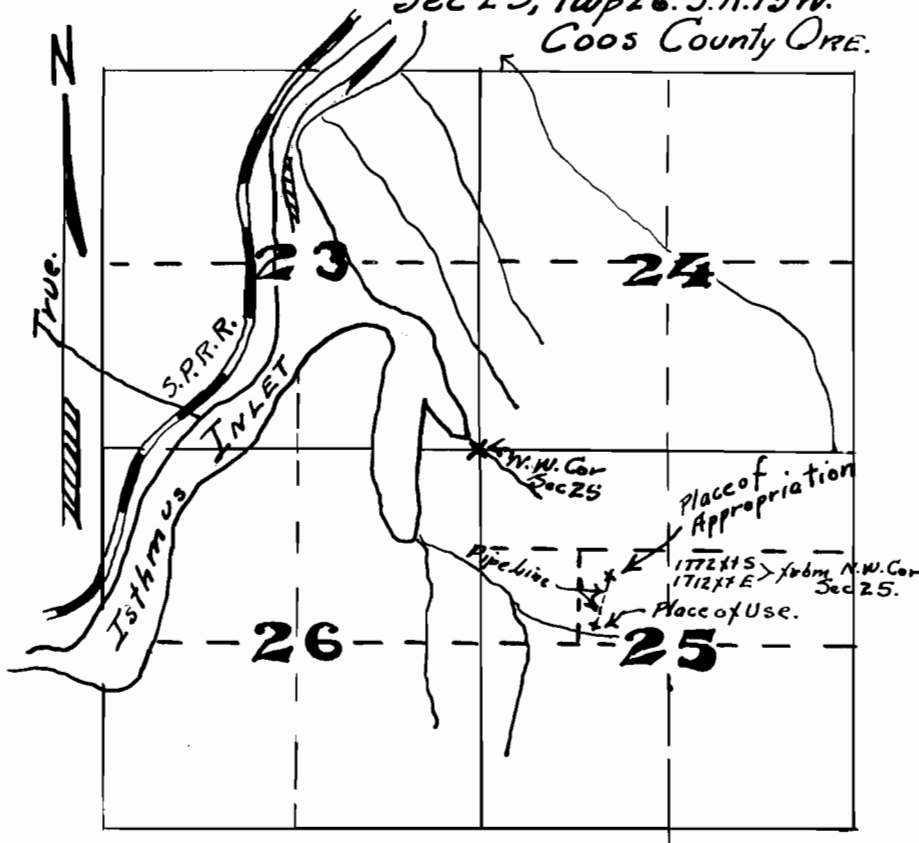

Scale  
One inch = 1/2 mile

I, D. L. Buckingham, of Marshfield Ore,  
do hereby certify that this map was made  
from notes taken during an actual survey made  
by me July 26 1929, and that it correctly rep-  
resents the works described in the accompanying  
application together with the location of  
the streams in the immediate vicinity

D. L. Buckingham