

CLAIM OF BENEFICIAL USE MAP

UNDER APPLICATION R-82506; PERMIT R-12263

SW1/4 SW1/4 SEC 34 T 20S R 37E W.M.

U.S.G.S. QUAD - PETES MOUNTAIN, OREG. - 7 1/2'

RECEIVED

AUG 26 2002

**WATER RESOURCES DEPT.
SALMON DIVISION**



LEGEND

○ RESERVOIR


--- TRAIL

--- CHANNEL

▲ TREE AREA

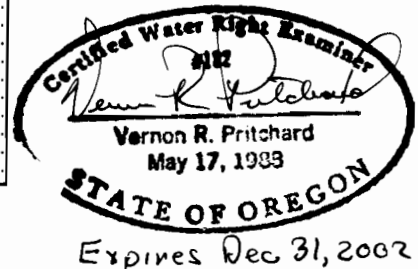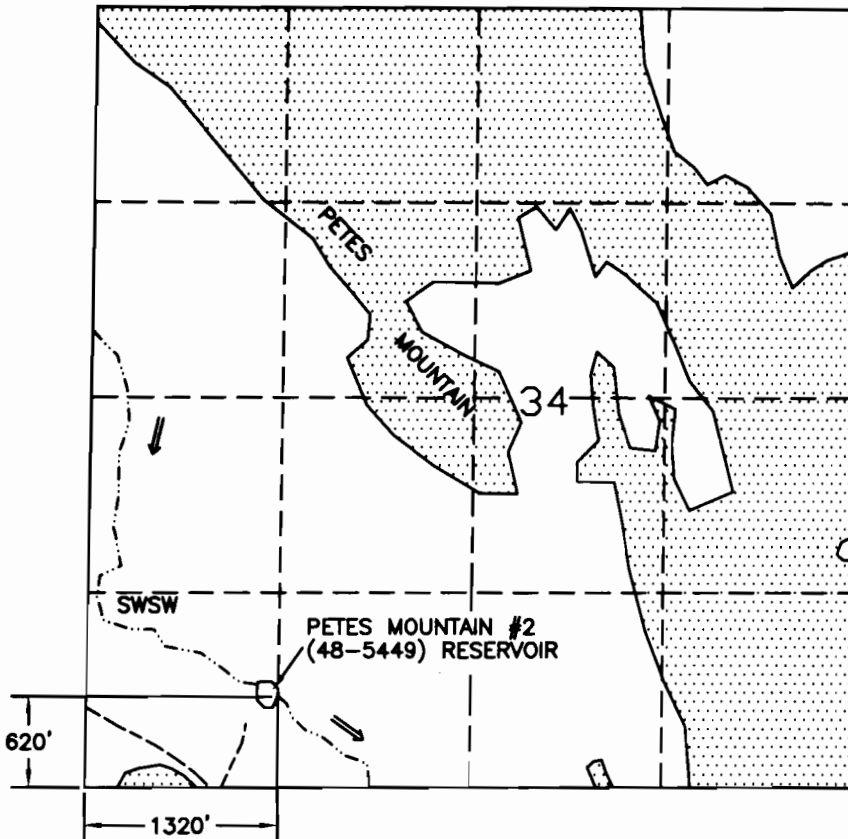

PETES MTN #2 (48-5449) RESERVOIR

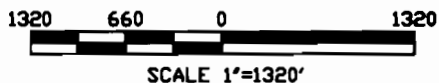

I, Thomas Terry, ADM Operations/Field Services agree to the findings of the CWRE and do submit this site report and map as my Claim of Beneficial Use of the water as provided under the terms and conditions of my Permit (R-12263).



THIS MAP IS FOR THE PURPOSE OF LOCATING A WATER RIGHT AND IS NOT INTENDED TO PROVIDE LEGAL DIMENSIONS FOR LOCATION OF PROPERTY BOUNDARIES.

ACAD2000/LDD
DWG FILE PETESTN2BEN

UNITED STATES DEPARTMENT OF THE INTERIOR
BUREAU OF LAND MANAGEMENT
DIVISION OF OPERATIONS VALE DISTRICT

PETES MTN. #2 (48-5449) RESERVOIR

DRAWN BY: [Signature]
SURVEYED: [Signature]
APPROVED: [Signature]
ADM OPERATIONS/AND FIELD SERVICES
DRAWN: CG SCALE: 1"=1320'
DATE: 11/01/01 SHEET 1 OF 1
DRAWING NO. OR-03-9172.45-1090