

CLAIM OF BENEFICIAL USE MAP


UNDER APPLICATION R-82504; PERMIT R-12261

NE1/4 SE1/4 SEC 21 T 21S R 40E W.M.



U.S.G.S. QUD - TIMS PEAK, OREG. - 7 1/2'

LEGEND

- RESERVOIR
- CHANNEL
- FD SEC COR

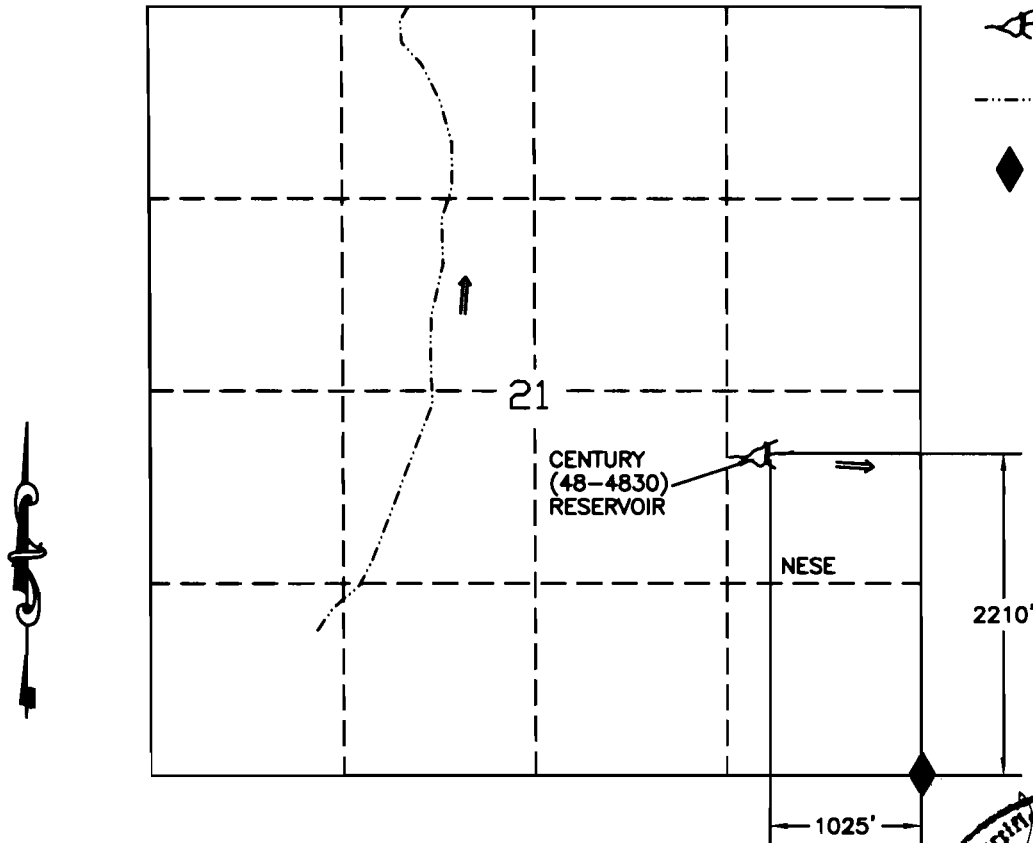

CENTURY (48-4830) RESERVOIR

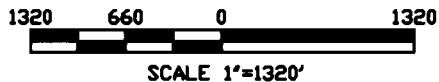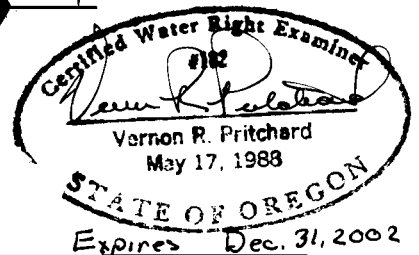

I, THOMAS TERRY, ADM Operations/Field Services agree to the findings of the CWRE and do submit this site report and map as my Claim of Beneficial Use of the water as provided under the terms and conditions of my Permit R-12261.

Thomas Terry



THIS MAP IS FOR THE PURPOSE OF LOCATING A WATER RIGHT AND IS NOT INTENDED TO PROVIDE LEGAL DIMENSIONS FOR LOCATION OF PROPERTY BOUNDARIES.

ACAD2000/LDD
DWG FILECENTURYBEN

UNITED STATES DEPARTMENT OF THE INTERIOR BUREAU OF LAND MANAGEMENT DIVISION OF OPERATIONS VALE DISTRICT	
CENTURY (48-4830) RESERVOIR	
DRAWN BY: <i>Vernon R. Pritchard</i>	
SURVEYED: <i>Thomas Terry</i>	
APPROVED: <i>Thomas Terry</i> ADM OPERATIONS AND FIELD SERVICES	
DRAWN: CG	SCALE: 1"=1320'
DATE: 10/31/01	SHEET 1 OF 1
DRAWING NO. OR-03-9172.45-00	