

RECEIVED

OCT 01 2001

WATER RESOURCES DIV. U.S. DEPT. OF THE INTERIOR


# CLAIM OF BENEFICIAL USE MAP

UNDER APPLICATION R-82502 ; PERMIT R-12259

W1/4 COR  
SEC. 16  
T.26S., R.41E., W.M.

SE1/4 NW1/4 SEC 21 T 26S R 41E W.M.

U.S.G.S. QUAD - CEDAR MTN., OREG. - 7 1/2'

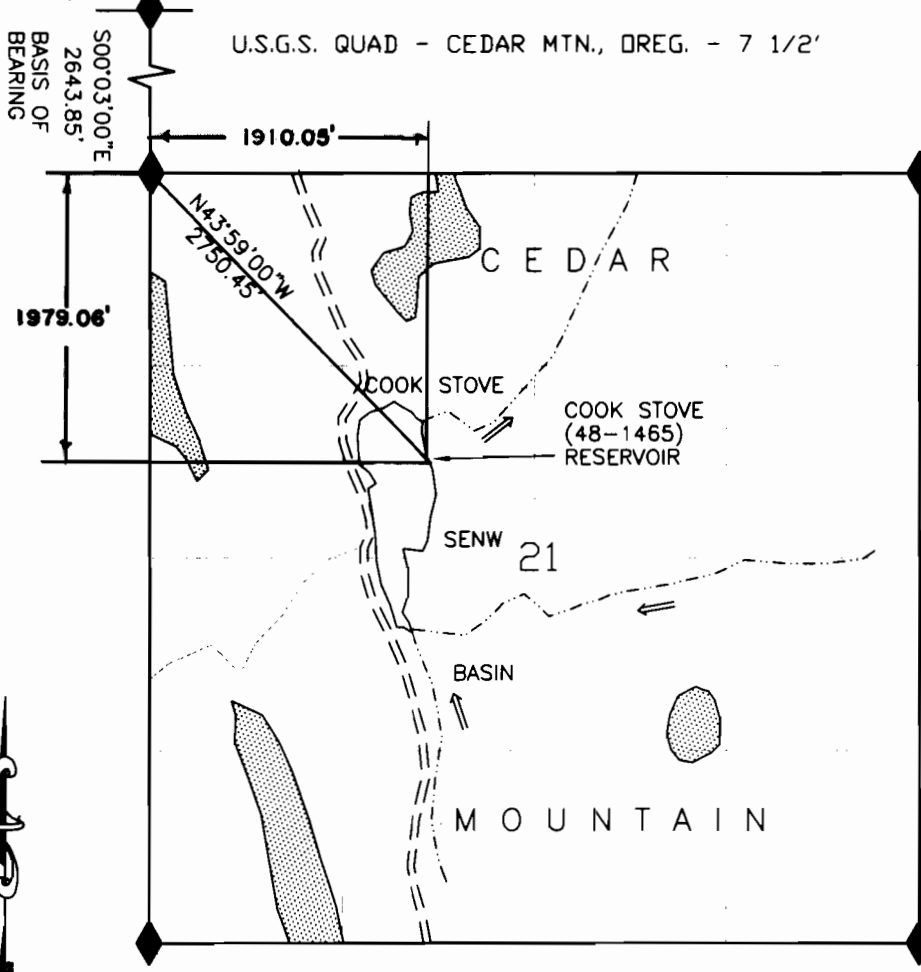


- LEGEND**
- RESERVOIR
  - ROAD
  - TRAIL
  - CHANNEL
  - FD SEC COR
  - TREE AREA

Certified Water Right Examiner  
 1982  
*Vernon R. Strickland*  
 Vernon R. Strickland  
 May 17, 1991  
 STATE OF OREGON

Expires 12/31/02

## COOK STOVE (48-1465) RESERVOIR

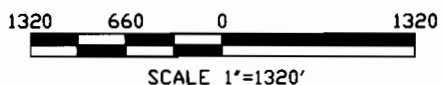

I, *Vernon R. Strickland* Acting ADM Operations/Field Services agree to the findings of the CWRE and do submit this site report and map as my Claim of Beneficial Use of the water as provided under the terms and conditions of my Permit R-12259.

*Vernon R. Strickland*



THIS MAP IS FOR THE PURPOSE OF LOCATING A WATER RIGHT AND IS NOT INTENDED TO PROVIDE LEGAL DIMENSIONS FOR LOCATION OF PROPERTY BOUNDARIES.

ACAD14  
 DWG FILE:COOKSTOBE

UNITED STATES DEPARTMENT OF THE INTERIOR BUREAU OF LAND MANAGEMENT DIVISION OF OPERATIONS VALE DISTRICT	
COOK STOVE (48-1465) RESERVOIR	
DRAWN BY:	<i>Vernon R. Strickland</i>
SURVEYED:	<i>Vernon R. Strickland</i>
APPROVED	<i>Vernon R. Strickland</i> ADM OPERATIONS AND FIELD SERVICES
DRAWN: CG	SCALE: 1"=1320'
DATE: 11/02/00	SHEET 1 OF 1
DRAWING NO. OR-03-9172.45-1076	