

CLAIM OF BENEFICIAL USE MAP

UNDER APPLICATION R-82500; PERMIT R-12258


SE1/4 SW1/4 SEC 1 T 17S R 40E W.M.

U.S.G.S. QUAD - LOG CREEK, OREG. - 7 1/2'

RECEIVED

AUG 20 2002

**WATER RESOURCES DEPT.
SALMON, OREGON**

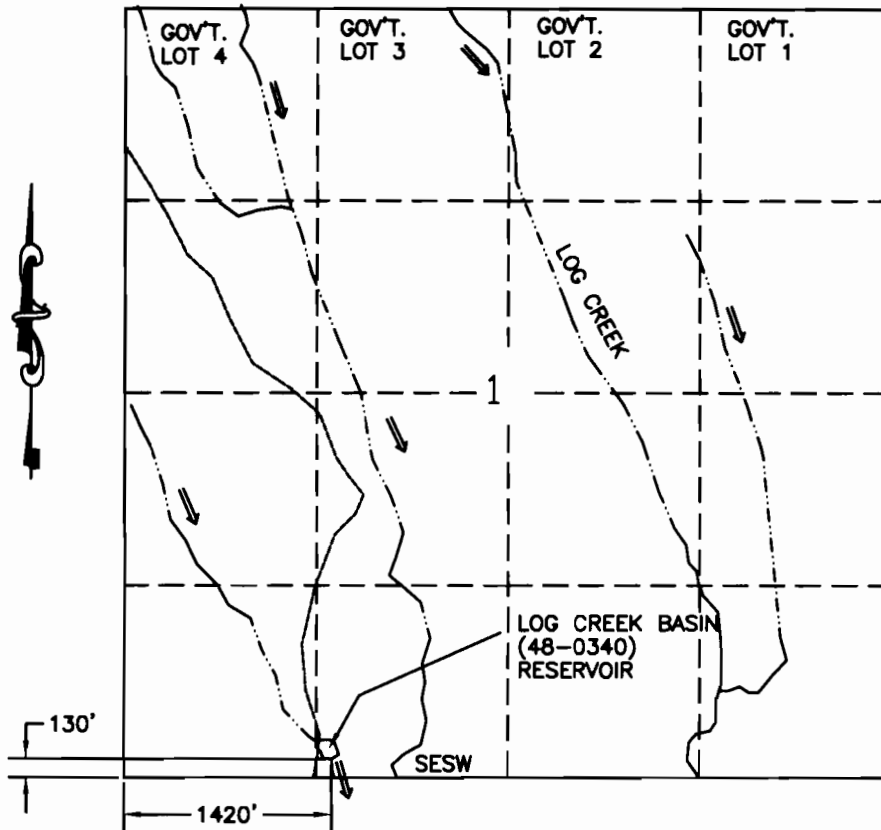

LEGEND

○ RESERVOIR


— TRAIL

- - - CHANNEL



Expires Dec. 31, 2002

LOG CREEK BASIN (48-0340) RESERVOIR

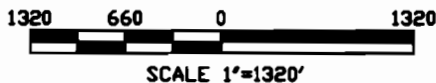

I, Thomas Terry, ADM Operations/Field Services agree to the findings of the CWRE and do submit this site report and map as my Claim of Beneficial Use of the water as provided under the terms and conditions of my Permit R-12258.



THIS MAP IS FOR THE PURPOSE OF LOCATING A WATER RIGHT AND IS NOT INTENDED TO PROVIDE LEGAL DIMENSIONS FOR LOCATION OF PROPERTY BOUNDARIES.

ACAD2000/LDD
DWG FILE LOGCRBASBEN

UNITED STATES DEPARTMENT OF THE INTERIOR BUREAU OF LAND MANAGEMENT DIVISION OF OPERATIONS VALE DISTRICT	
LOG CREEK BASIN (48-0340) RESERVOIR	
DRAWN BY: <u>Thomas Terry</u>	
SURVEYED: <u>Thomas Terry</u>	
APPROVED: <u>Thomas Terry</u>	ADM OPERATIONS AND FIELD SERVICES
DRAWN: CG	SCALE: 1"=1320'
DATE: 11/01/01	SHEET 1 OF 1
DRAWING NO. OR-03-9172.45-1086	