

RECEIVED

FEB 11 1998


WATER RESOURCES DEPT.
SALEM, OREGON

T. 38 S., R. 6 E., W.M.

RECEIVED

MAY - 2 1997

WATER RESOURCES DEPT.
SALEM, OREGON

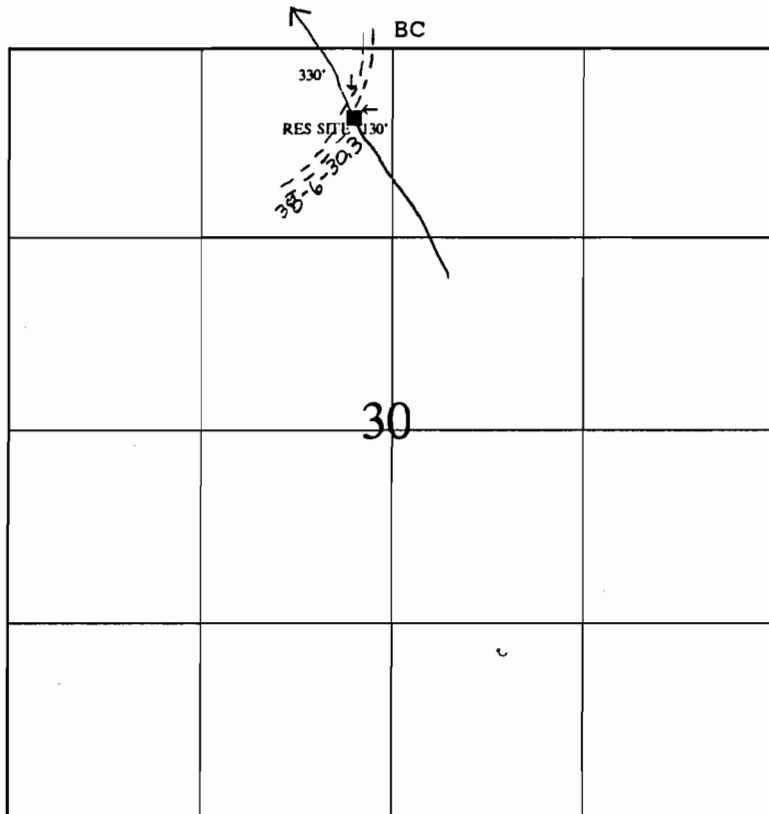

N



1" = 1320'

Application No.
Permit No.

83.421
APPLICATION MAP
R12344 FOR
MICRO LAKE

IN NAME OF

UNITED STATES BUREAU OF LAND MANAGEMENT
LAKEVIEW DISTRICT

JULY 30, 1996

THE PURPOSE OF THIS MAP IS FOR IDENTIFYING THE LOCATION OF THE WATER RIGHT ONLY AND
IS NOT INTENDED TO PROVIDE LEGAL DIMENSIONS OR LOCATION OF PROPERTY OWNERSHIP LINES.

BLM PROJECT NO. OR-010-R-6524

WRE 6154A OREGON

U.S. BUREAU OF LAND MANAGEMENT - OSO
BRANCH OF GEOGRAPHIC SCIENCES
LETTER OF AUTHORIZATION
DATED: JULY 12, 1996

EXECUTED BY:
ROBERT W. DAHL, RLS, CWRE
P.O. BOX 1374
WALDPORT, OREGON 97394

