


CLAIM OF BENEFICIAL USE MAP

UNDER APPLICATION R-81926; PERMIT R-12296

NW1/4 SW1/4 SEC 3 T 11S R 43E W.M.

U.S.G.S. QUAD - LAWRENCE CREEK, OREG. - 7 1/2'

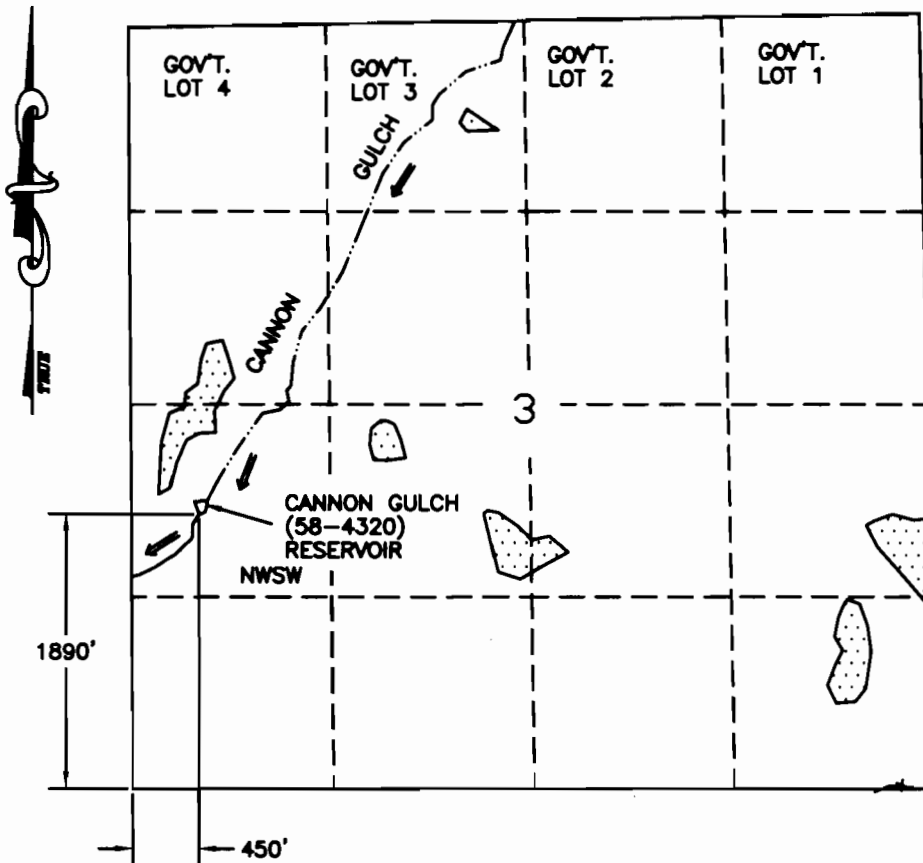

Expires Dec 31, 2002

LEGEND

- ▽ RESERVOIR
- ◻ FORESTED AREA
- CHANNEL
- x- FENCE

RECEIVED

AIR 9 8 2002

**WATER RESOURCES DEPT.
SALMON, OREGON**

CANNON GULCH (58-4320) RESERVOIR

1320 660 0 1320

SCALE 1"=1320'

I, Thomas Terry, ADM Operations/Field Services agree to the findings of the CWRE and do submit this site report and map as my Claim of Beneficial Use of the water as provided under the terms and conditions of my Permit.

**ALWAYS
THINK
SAFETY**

THIS MAP IS FOR THE PURPOSE OF LOCATING A WATER RIGHT AND IS NOT INTENDED TO PROVIDE LEGAL DIMENSIONS FOR LOCATION OF PROPERTY BOUNDARIES.

ACAD2000/LDD
DWG FILE:CANONGLIBEN

UNITED STATES DEPARTMENT OF THE INTERIOR
BUREAU OF LAND MANAGEMENT
DIVISION OF OPERATIONS VALE DISTRICT

CANNON GULCH (58-4320) RESERVOIR

DRAWN BY: Vernon R. Pritchard
SURVEYED: Vernon R. Pritchard
APPROVED: Vernon R. Pritchard
ADM OPERATIONS AND FIELD SERVICES

DRAWN: CG SCALE: 1"=1320'

DATE: 10/31/01 SHEET 1 OF 1

DRAWING NO. OR-03-9172.45-00