


T. 24 S., R. 24 E., W.M.

RECEIVED

AUG 30 1999
WATER RESOURCES DEPT.
SALEM, OREGON

DIVERSION IS 3815
FEET SOUTH AND
6700 FEET EAST
OF THE NW CORNER
OF SECTION 6.

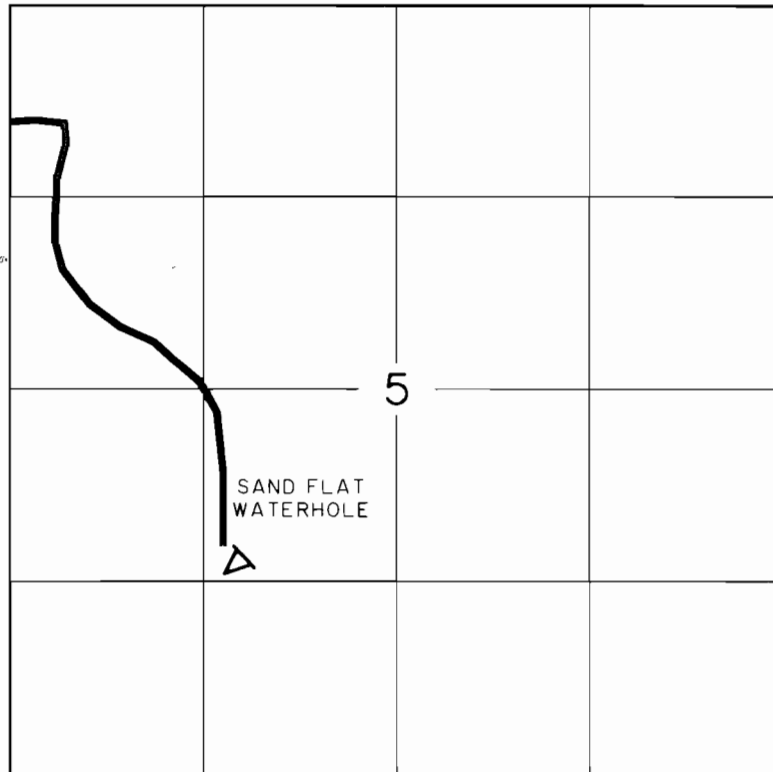

1" = 1320'


CLAIM OF BENEFICIAL USE MAP

IN NAME OF

UNITED STATES BUREAU OF LAND MANAGEMENT

APPLICATION NO. R-73142

PERMIT NO. R-11614

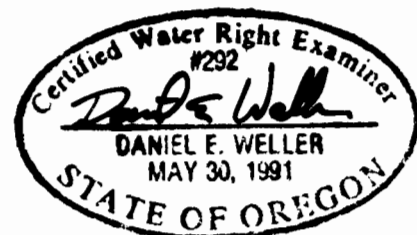

EXPIRES 6/30/00

SURVEYED: JUNE 15, 1999

THE PURPOSE OF THIS MAP IS FOR IDENTIFYING THE LOCATION OF THE WATER RIGHT ONLY AND
IS NOT INTENDED TO PROVIDE LEGAL DIMENSIONS OR LOCATION OF PROPERTY OWNERSHIP LINES.

U.S. BUREAU OF LAND MANAGEMENT-OSO
BRANCH OF GEOGRAPHIC SCIENCES

DWG: SANDFLAT

EXECUTED BY:
DANIEL E. WELLER, PLS, CWRE
P.O. BOX 2965
PORTLAND, OREGON 97208