


RECEIVED

SECTION 23, T.2 S., R.2 W., W.M.
WASHINGTON COUNTY, OREGON

SEP 08 1999
WATER RESOURCES DEPT.
SALEM, OREGON

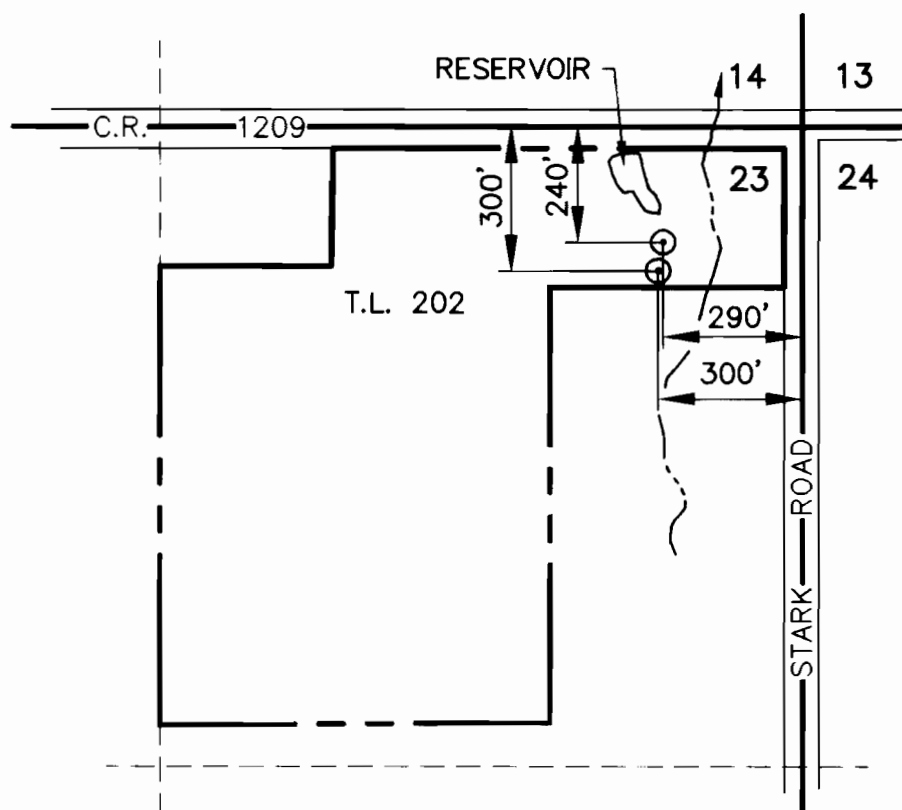

SCALE: 1"=400'

MAP BASE:
ASSESSORS MAP
DLUT PHOTO



PREPARATION OF THIS MAP IS FOR THE
PURPOSE OF IDENTIFYING THE LOCATION OF
THE WATER RIGHT ONLY. IT DOES NOT
TO PROVIDE DIMENSIONS OR LOCATION OF
PROPERTY OWNERSHIP LINES.

FINAL PROOF SURVEY

UNDER

APPLICATION R-73347 PERMIT R-11577
SURVEYED AUGUST 18, 1999

VERBOORT ENGINEERING

AGRICULTURE · CIVIL · WATER RESOURCES
HILLSBORO, OREGON

	by	date
designed	WRV	9/20/99
drawn	WRV	9/20/99
checked	WRV	9/20/99
drawing no.	99-A-10	
sheet no.	1 / 1	

RICHARD H. STARK

20680 S.W. SCHOLLS-SHERWOOD RD.
SHERWOOD, OR 97140