


T. 19 S., R. 31 E., W.M.

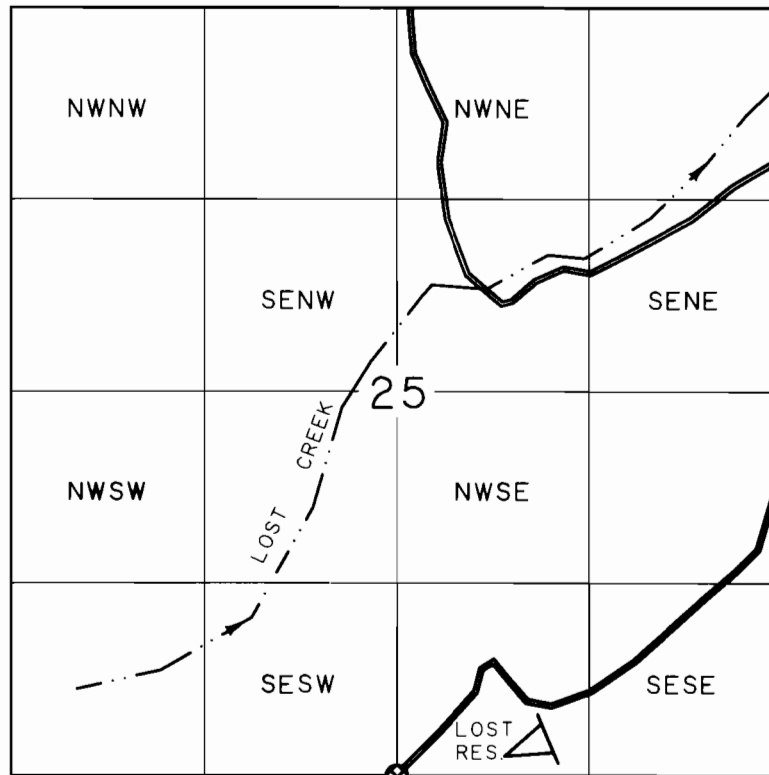

B.C.

DIVERSION IS 289
FEET NORTH AND
871 FEET EAST
OF THE S 1/4 COR.
OF SECTION 25.



1" = 1320'

RECEIVED

AUG 30 1999

**WATER RESOURCES DEPT.
SALEM, OREGON**


CLAIM OF BENEFICIAL USE MAP

IN NAME OF

UNITED STATES BUREAU OF LAND MANAGEMENT

APPLICATION NO. R-72287

PERMIT NO. R-11843

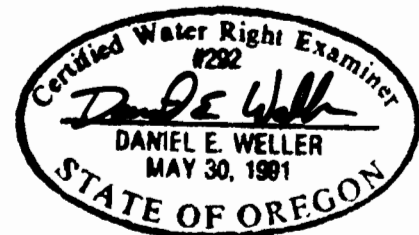

EXPIRES 6/30/00

SURVEYED: JUNE 16, 1999

THE PURPOSE OF THIS MAP IS FOR IDENTIFYING THE LOCATION OF THE WATER RIGHT ONLY AND
IS NOT INTENDED TO PROVIDE LEGAL DIMENSIONS OR LOCATION OF PROPERTY OWNERSHIP LINES

U.S. BUREAU OF LAND MANAGEMENT-OSO
BRANCH OF GEOGRAPHIC SCIENCES

DWG: LOST

EXECUTED BY:
DANIEL E. WELLER, PLS, CWRE
P.O. BOX 2965
PORTLAND, OREGON 97208