


T. 9S., R. 42E., W.M.

RECEIVED

SEP 30 1999

WATER RESOURCES DEPT
SALEM, OREGON

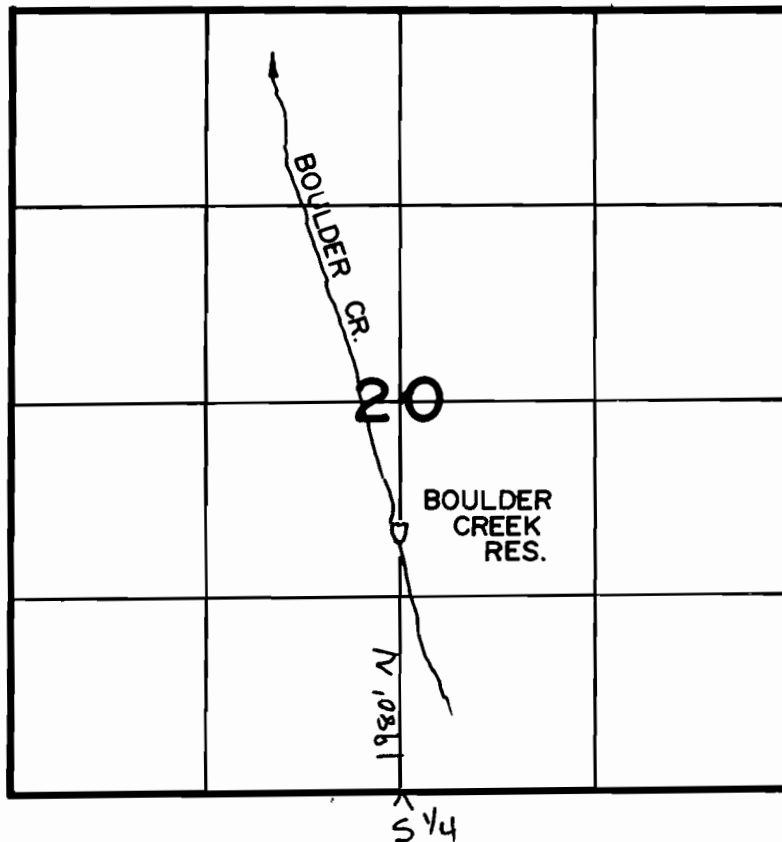

SCALE 1" = 1320'

The purpose of this map is for identifying the location of the water right only and is not intended to provide legal dimensions of property ownership lines

FINAL PROOF SURVEY


UNDER

APPL. R-71116

PER. 11585

IN NAME OF
FLEMING LOVING TRUST

Surveyed Sept. 23, 1999

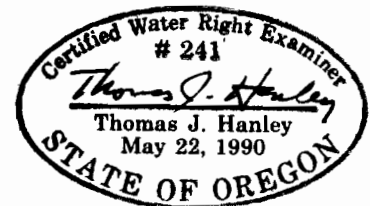

Map amended by WRD Staff 8-19-2008
jwg