
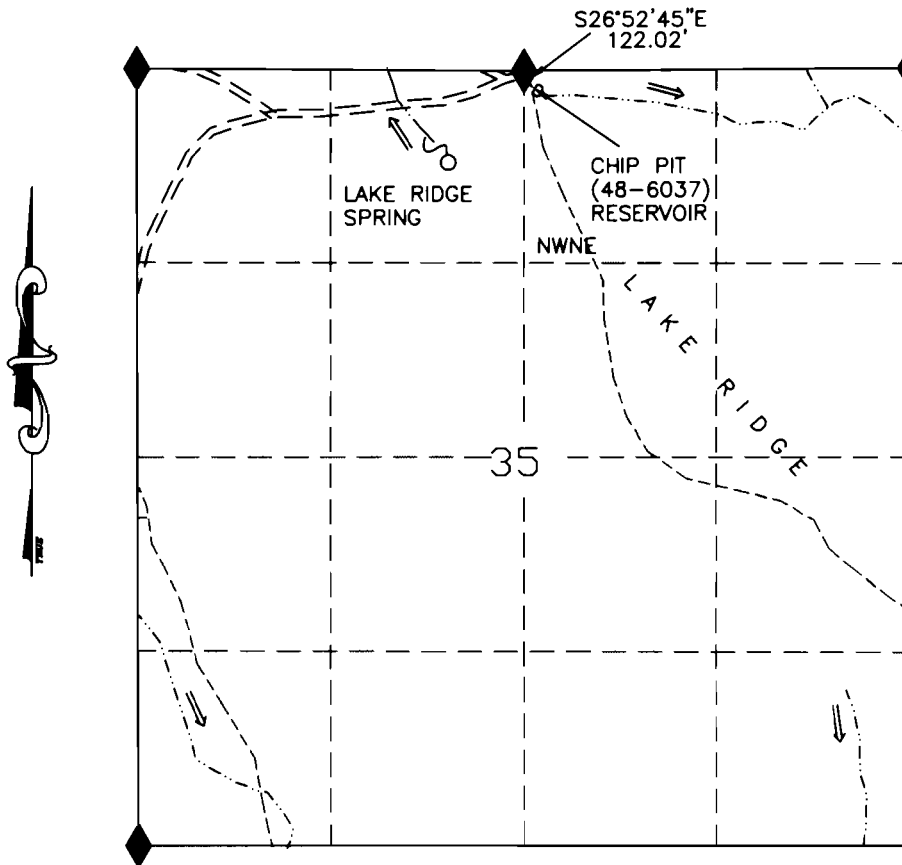


CLAIM OF BENEFICIAL USE MAP

UNDER APPLICATION R-81946; PERMIT R-12257

NW1/4 NE1/4 SEC 35 T 22S R 39E W.M.

U.S.G.S. QUAD - SHUMWAY RESERVOIR, OREG. - 7 1/2'

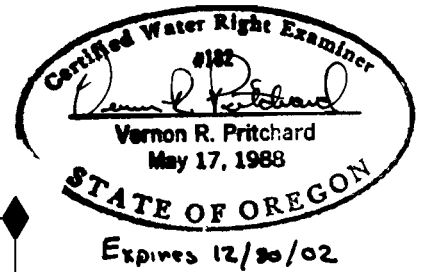

LEGEND

- o RESERVOIR
- == ROAD
- CHANNEL
- ◆ FD SEC COR
- TRAIL
- o SPRING

CHIP PIT (48-6037) RESERVOIR

RECEIVED
SEP 21 1988
WATER RIGHTS DIVISION

1320 660 0 1320
SCALE 1"=1320'

I, Jerry Carter Acting ADM Operations/Field Services agree to the findings of the CWRE and do submit this site report and map as my Claim of Beneficial Use of the water as provided under the terms and conditions of my Permit R-12257

THIS MAP IS FOR THE PURPOSE OF LOCATING A WATER RIGHT AND IS NOT INTENDED TO PROVIDE LEGAL DIMENSIONS FOR LOCATION OF PROPERTY BOUNDARIES.



ACAD14
DWG FILE: CHIPPITBEN

UNITED STATES DEPARTMENT OF THE INTERIOR
BUREAU OF LAND MANAGEMENT
DIVISION OF OPERATIONS VALE DISTRICT

CHIP PIT (48-6037)
RESERVOIR

DRAWN BY: Vernon R. Pritchard
SURVEYED: Jerry Carter
APPROVED: Jerry Carter
ADM OPERATIONS AND FIELD SERVICES

DRAWN: CG SCALE: 1"=1320'

DATE: 11/02/00 SHEET 1 OF 1

DRAWING NO. OR-03-9172.45-1075