


CLAIM OF BENEFICIAL USE MAP

UNDER APPLICATION R-81929; PERMIT R-12299

NE1/4NE1/4 SEC 27 T 7S R 41E W.M.

U.S.G.S. QUAD - KEATING NW, OREG. - 7 1/2'

RECEIVED
OCT 8 1 2001
WATER RESOURCES DIV.
CLERK, OREGON

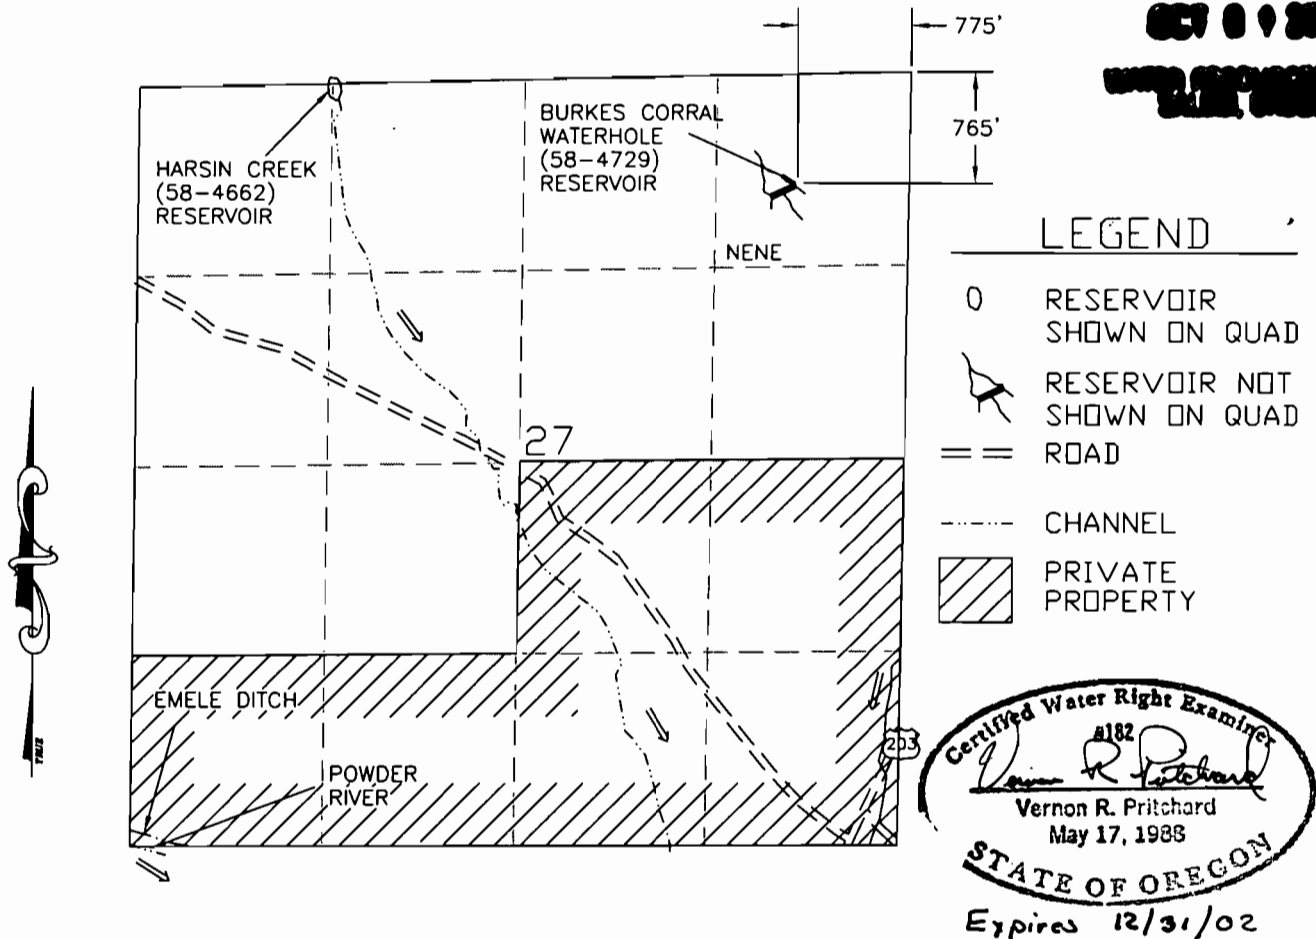

BURKES CORRAL WATERHOLE (58-4729) RESERVOIR

1320 660 0 1320
SCALE 1"=1320'

I, *[Signature]*, Acting ADM Operations/Field Services agree to the findings of the CWRE and do submit this site report and map as my Claim of Beneficial Use of the water as provided under the terms and conditions of my Permit R-12299.

THIS MAP IS FOR THE PURPOSE OF LOCATING A WATER RIGHT AND IS NOT INTENDED TO PROVIDE LEGAL DIMENSIONS FOR LOCATION OF PROPERTY BOUNDARIES.



ACAD2000i
DWG FILE: BURKECBEN.DWG

UNITED STATES DEPARTMENT OF THE INTERIOR BUREAU OF LAND MANAGEMENT DIVISION OF OPERATIONS VALE DISTRICT	
BURKES CORRAL WATERHOLE (58-4729) RESERVOIR	
DRAWN BY:	<i>[Signature]</i>
SURVEYED:	<i>[Signature]</i>
APPROVED	<i>[Signature]</i> ADM OPERATIONS AND FIELD SERVICES
DRAWN: CG	SCALE: 1"=1320'
DATE: 08/22/01	SHEET 1 OF 1
DRAWING NO. OR-03-9172.45-00	