

AREA INCLUDES A PORTION OF
T 17 S, R 6 W, W.M.

RECEIVED



AUG 26 1999

WATER RESOURCES DEPT.
SALEM, OREGON

THE PURPOSE OF THIS MAP IS TO IDENTIFY THE LOCATION
OF THE WATER RIGHTS. IT IS NOT INTENDED TO PROVIDE
INFORMATION RELATIVE TO THE LOCATION OF PROPERTY
OWNERSHIP BOUNDARY LINES.



SCALE: 1" = 400'

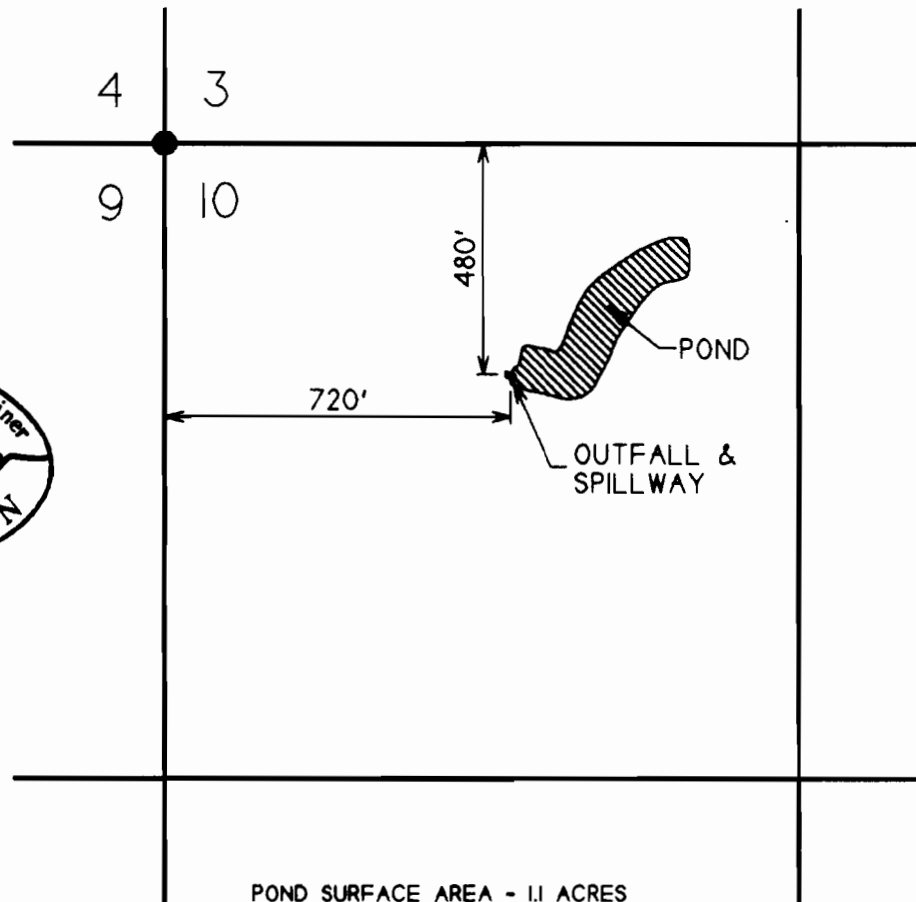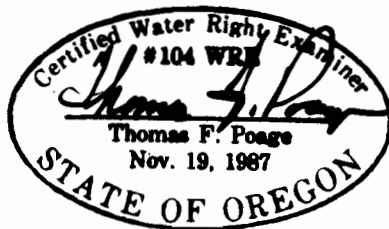

**FINAL PROOF SURVEY
UNDER**

APPLICATION NO. R-71830

PERMIT NO. R-11515

IN NAME OF

VINCENT KYCEK

SURVEYED AUGUST 12, 1991 BY JAO
CADD FILE: 166IPROF.GCD

DRAWN: 8/17/99 DPS