

CLAIM OF BENEFICIAL USE

Application No. R-72333
Permit No. R-11862
Tax Lot No. 10 40 4100
Baker County



Application No. R-72334
Permit No. R-11863
Tax Lot No. 10 40 6100, 6200 & 6500
Baker County

Applicant:

Eugene M. & Joan E. Davilla
HCR 87, Box 576
Baker City, OR 97814



Scale: 1" = 2,000'

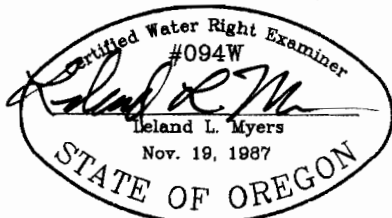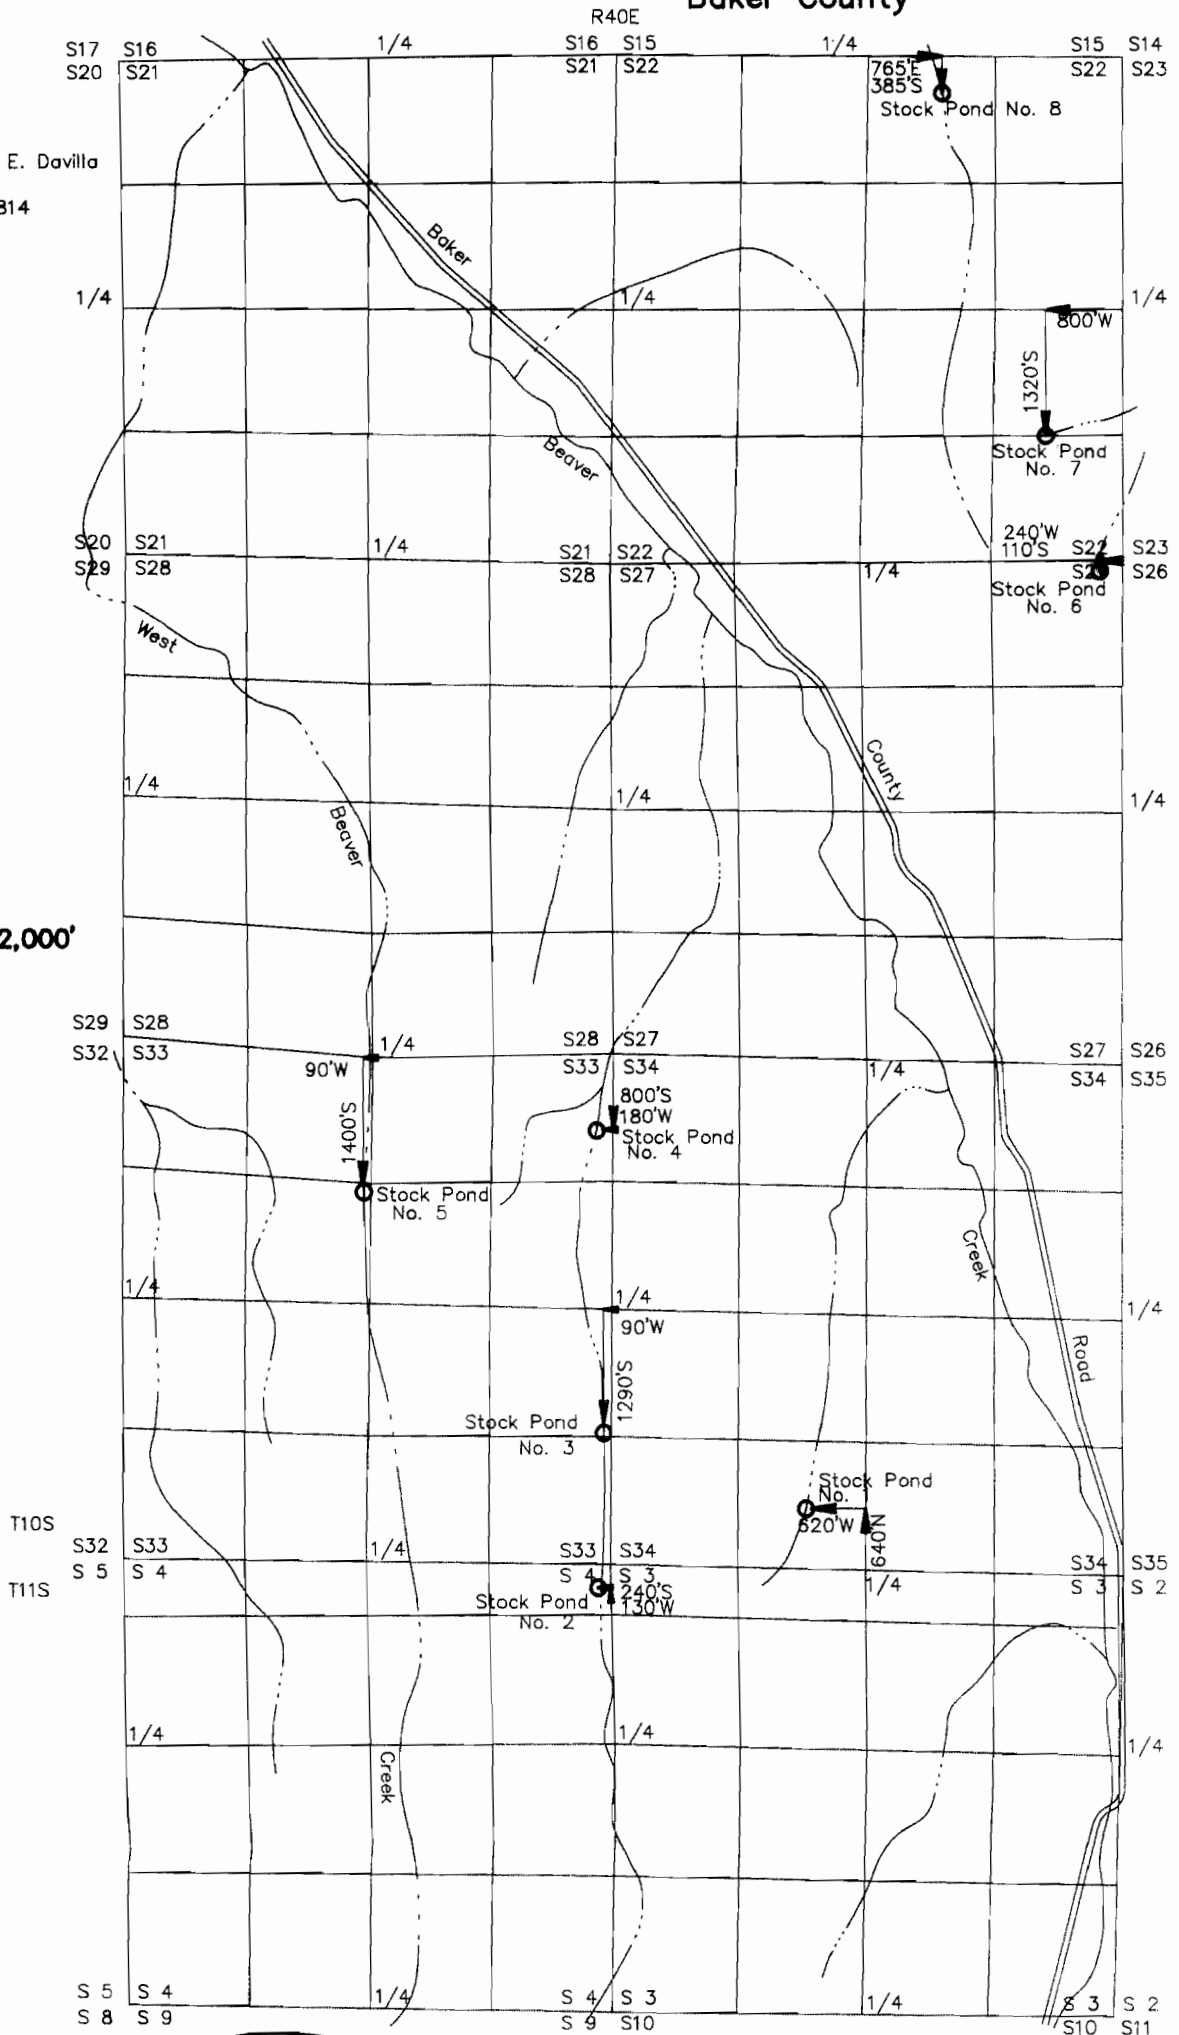

This map is for the purpose of identifying the location of the water right and has no intent to provide dimensions or location of property ownership lines.

RECEIVED

SEP 2 1988

WATER RESOURCES DEPT
SALEM, OREGON