

CLAIM OF BENEFICIAL USE MAP

UNDER APPLICATION R-82529; PERMIT R-12361


GOV'T. LOT 1 SEC 3 T 41S R 38E W.M.

U.S.G.S. QUD - CHICKEN SPRING, OREG. - 7 1/2'



LEGEND

- RESERVOIR
- ROAD
- CHANNEL
- FD SEC COR
- DISTRICT BOUNDARY
- SPRING
- FENCE

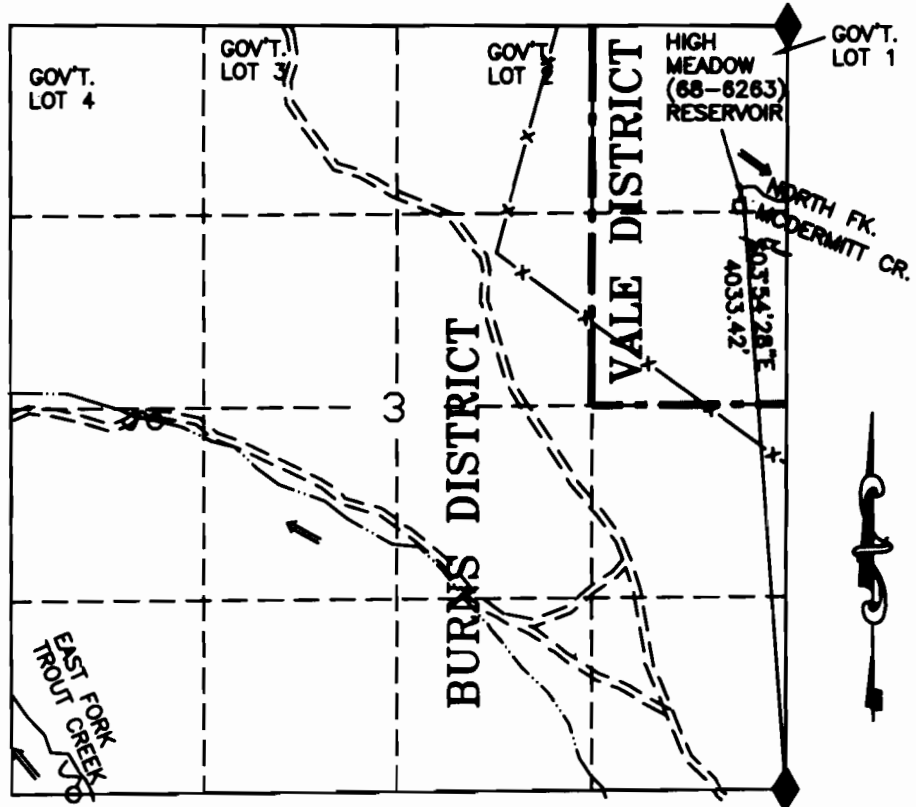

RECEIVED

HIGH MEADOW (68-6263) RESERVOIR

AIR 26 2002

**WATER RESOURCES DEPT.
SALMON, OREGON**

1320 660 0 1320



SCALE 1"=1320'

I, Thomas Tarr, ADM Operations/Field Services agree to the findings of the CWRE and do submit this site report and map as my Claim of Beneficial Use of the water as provided under the terms and conditions of my Permit R-12361



THIS MAP IS FOR THE PURPOSE OF LOCATING A WATER RIGHT AND IS NOT INTENDED TO PROVIDE LEGAL DIMENSIONS FOR LOCATION OF PROPERTY BOUNDARIES.

ACAD888/LB
DWG FILE:HIGHMEADBN

UNITED STATES DEPARTMENT OF THE INTERIOR BUREAU OF LAND MANAGEMENT DIVISION OF OPERATIONS VALE DISTRICT	
HIGH MEADOW (68-6263) RESERVOIR	
DRAWN BY: <u>[Signature]</u> SURVEYED: <u>[Signature]</u> APPROVED: <u>[Signature]</u> ADM OPERATIONS AND FIELD SERVICES	
DRAWN: CG	SCALE: 1"=1320'
DATE: 10/31/01	SHEET 1 OF 1
DRAWING NO. DR-03-9172.45-1083	