

BVD01 - Location Map

EXHIBIT B

M.G. COSGROVE

OCT. 1981


SEC. 19 4 30

TOWNSHIP 15

S. RANGE 32 E

W.M.

1" = 1000'

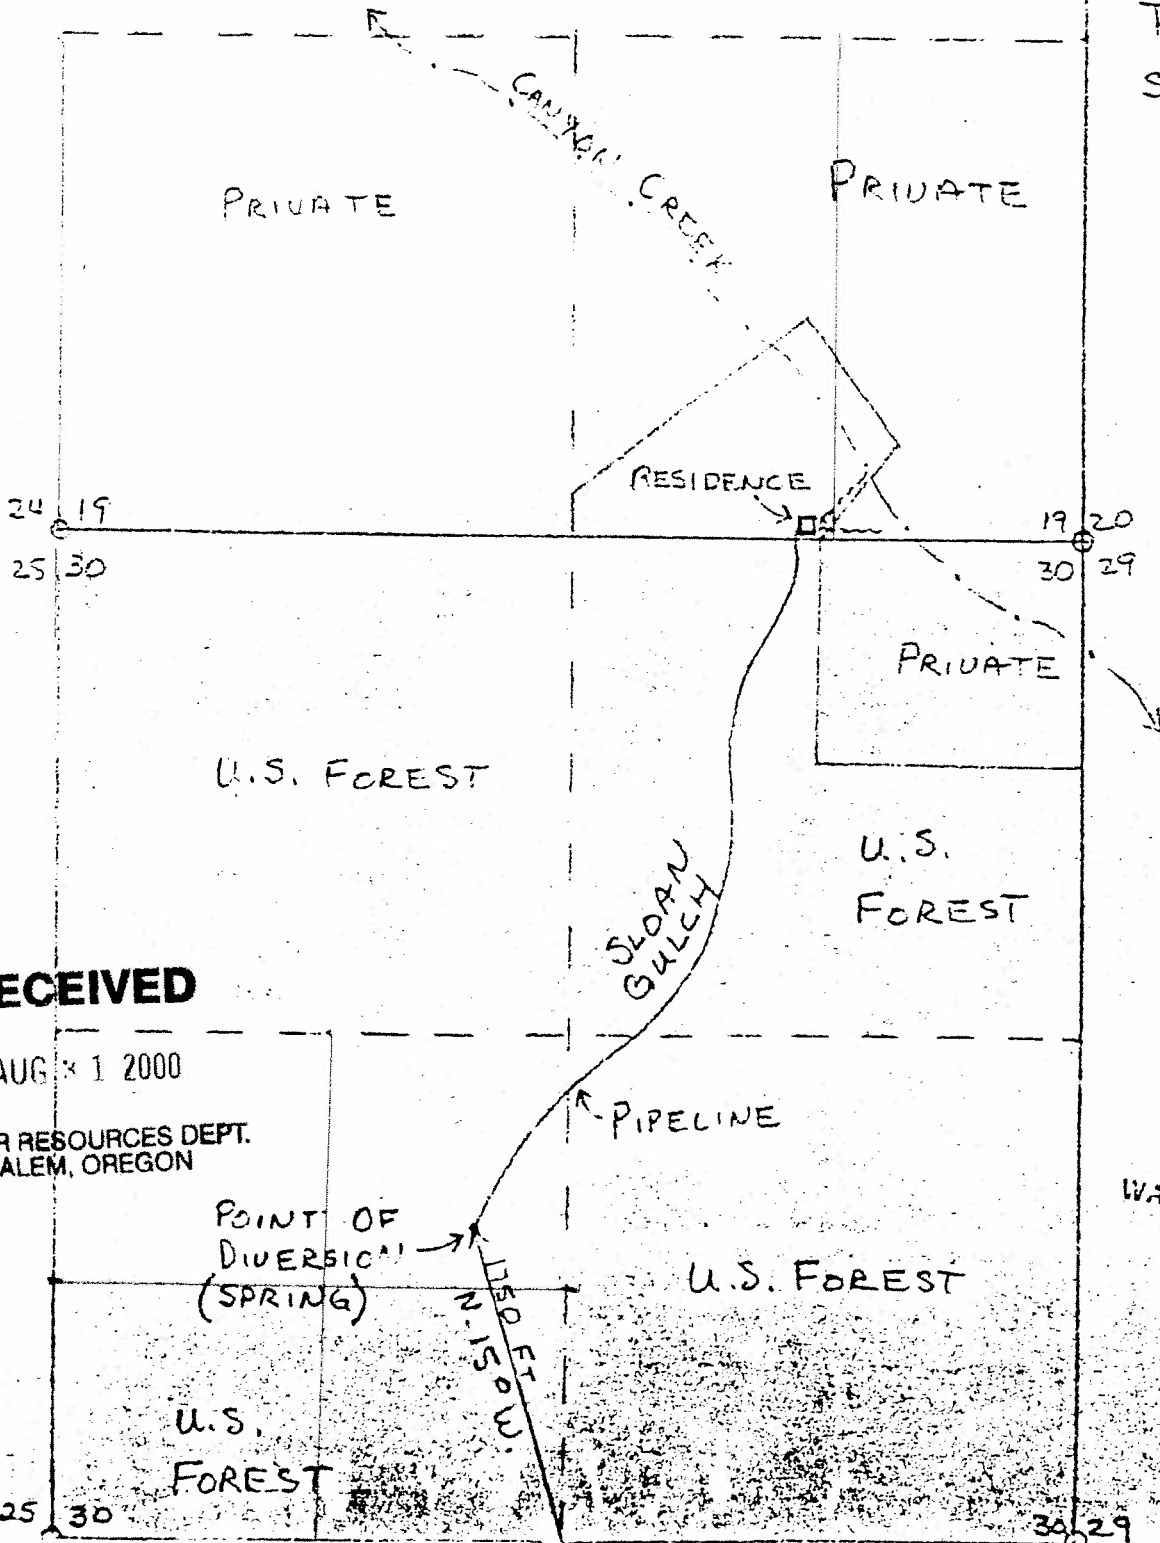

RECEIVED

AUG 31 2000

WATER RESOURCES DEPT.
SALEM, OREGON

RECEIVED

OCT 13 1981

WATER RESOURCES
SALEM, OREGON