


CLAIM OF BENEFICIAL USE MAP

UNDER APPLICATION R-81941; PERMIT R-12252

NW1/4 NW1/4 SEC 35 T 39S R 44E W.M.

U.S.G.S. QUAD - GRASSHOPPER FLAT SOUTH, OREG. - 7 1/2'

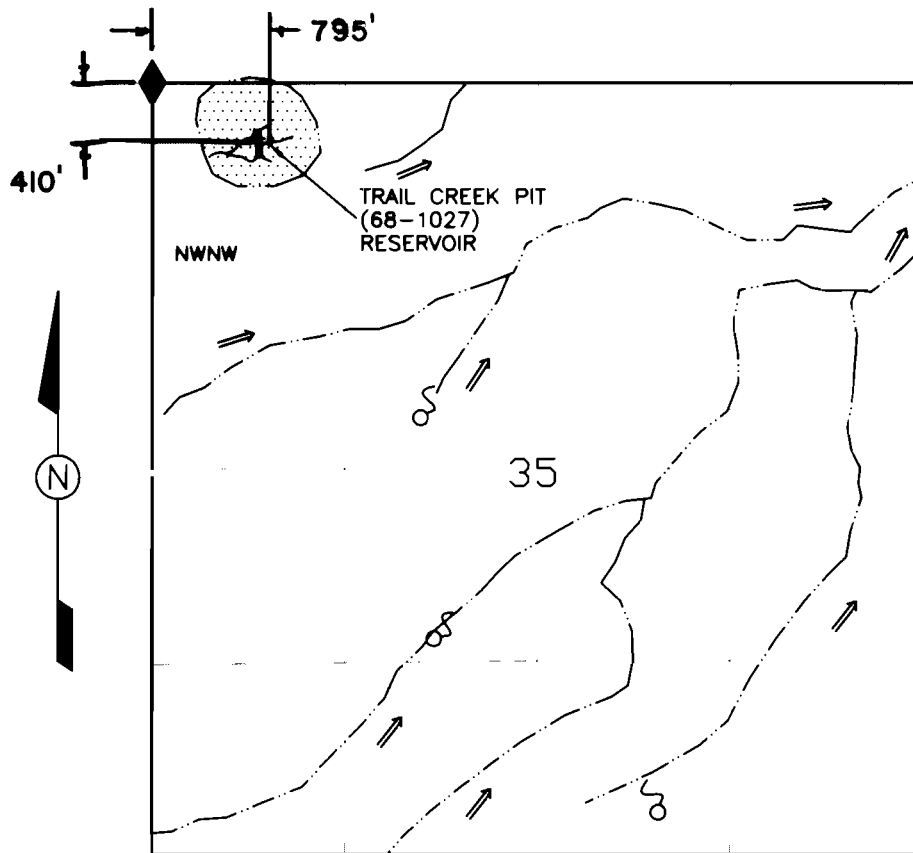


RECEIVED

OCT 8 1984

WATER RIGHTS DIVISION

LEGEND

- RESERVOIR
- SPRING
- CHANNEL
- FD SEC COR
- DRY LAKE BED

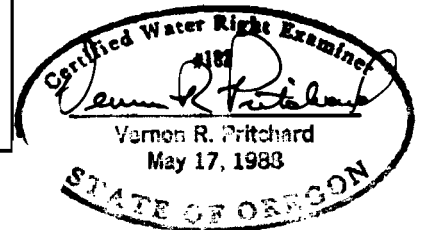

Expires 12/31/02

TRAIL CREEK PIT (68-1027) RESERVOIR

1320 660 0 1320
SCALE 1"=1320'

I, Vernon R. Pritchard, Acting ADM Operations/Field Services agree to the findings of the CWRE and do submit this site report and map as my Claim of Beneficial Use of the water as provided under the terms and conditions of my Permit R-12252.

THIS MAP IS FOR THE PURPOSE OF LOCATING A WATER RIGHT AND IS NOT INTENDED TO PROVIDE LEGAL DIMENSIONS FOR LOCATION OF PROPERTY BOUNDARIES.



ACAD14
DWG FILE: TRAILCRBEN

UNITED STATES DEPARTMENT OF THE INTERIOR BUREAU OF LAND MANAGEMENT DIVISION OF OPERATIONS VALE DISTRICT	
TRAIL CREEK PIT (68-1027) RESERVOIR	
DRAWN BY:	<u>Vernon R. Pritchard</u>
SURVEYED:	<u>Vernon R. Pritchard</u>
APPROVED:	<u>Vernon R. Pritchard</u> ADM/OPERATIONS AND FIELD SERVICES
DRAWN: CG	SCALE: 1"=1320'
DATE: 10/18/00	SHEET 1 OF 1
DRAWING NO. OR-03-9172.45-1063	