



FINAL PROOF MAP

UNDER APPLICATION No. 71152, PERMIT No. 52688

RECEIVED

JAN - 2 1998



WATER RESOURCES DEPT.
SALEM, OREGON

Applicant:

Walter S. Saunders, Jr.
Route 1 Box 21
Richland, OR 97870

Scale 1" = 400'

T9S R45E

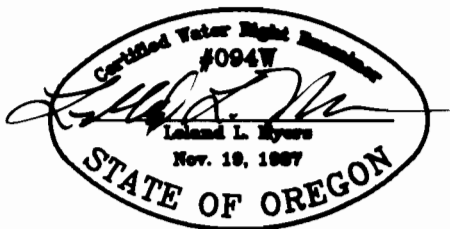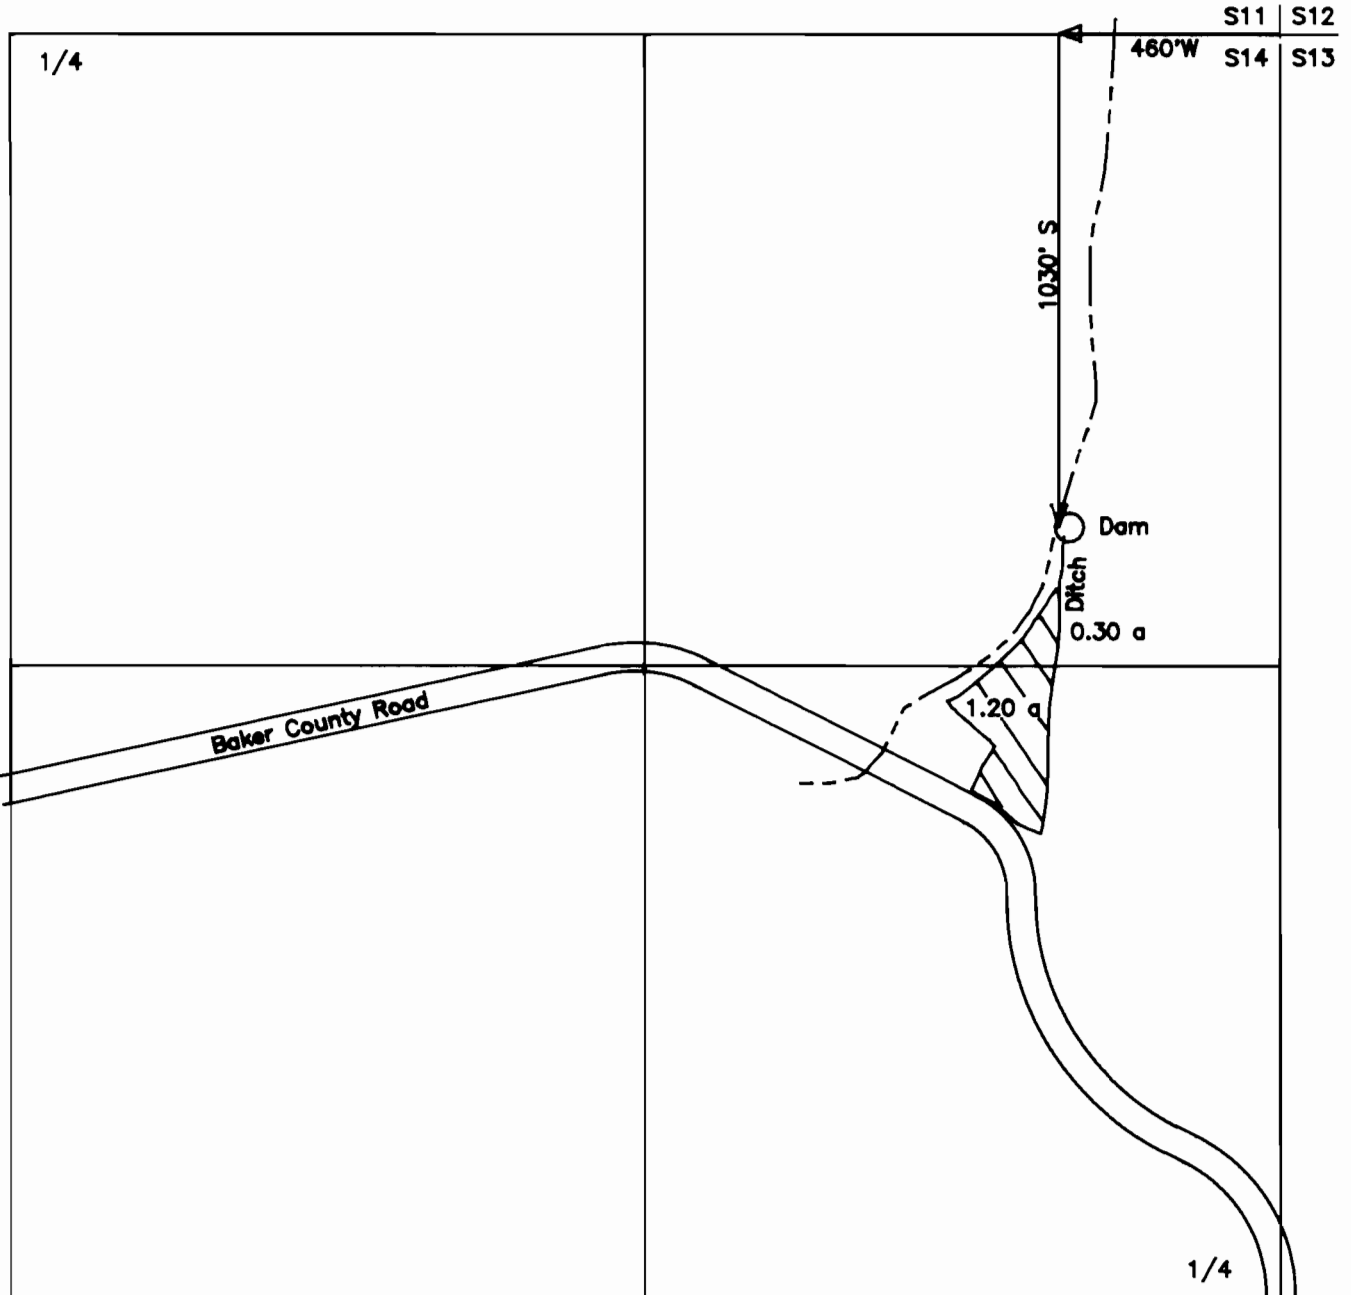

This map is for the purpose of identifying the location of the water right only and has no intent to provide dimensions or location of property ownership lines.