


FINAL PROOF SURVEY

IN THE NAME OF: HARLEY E. AND BETTY D. CISSNA

SECTION 9, T.2S., R.4E., W.M.

SCALE 1 inch = 400 FEET

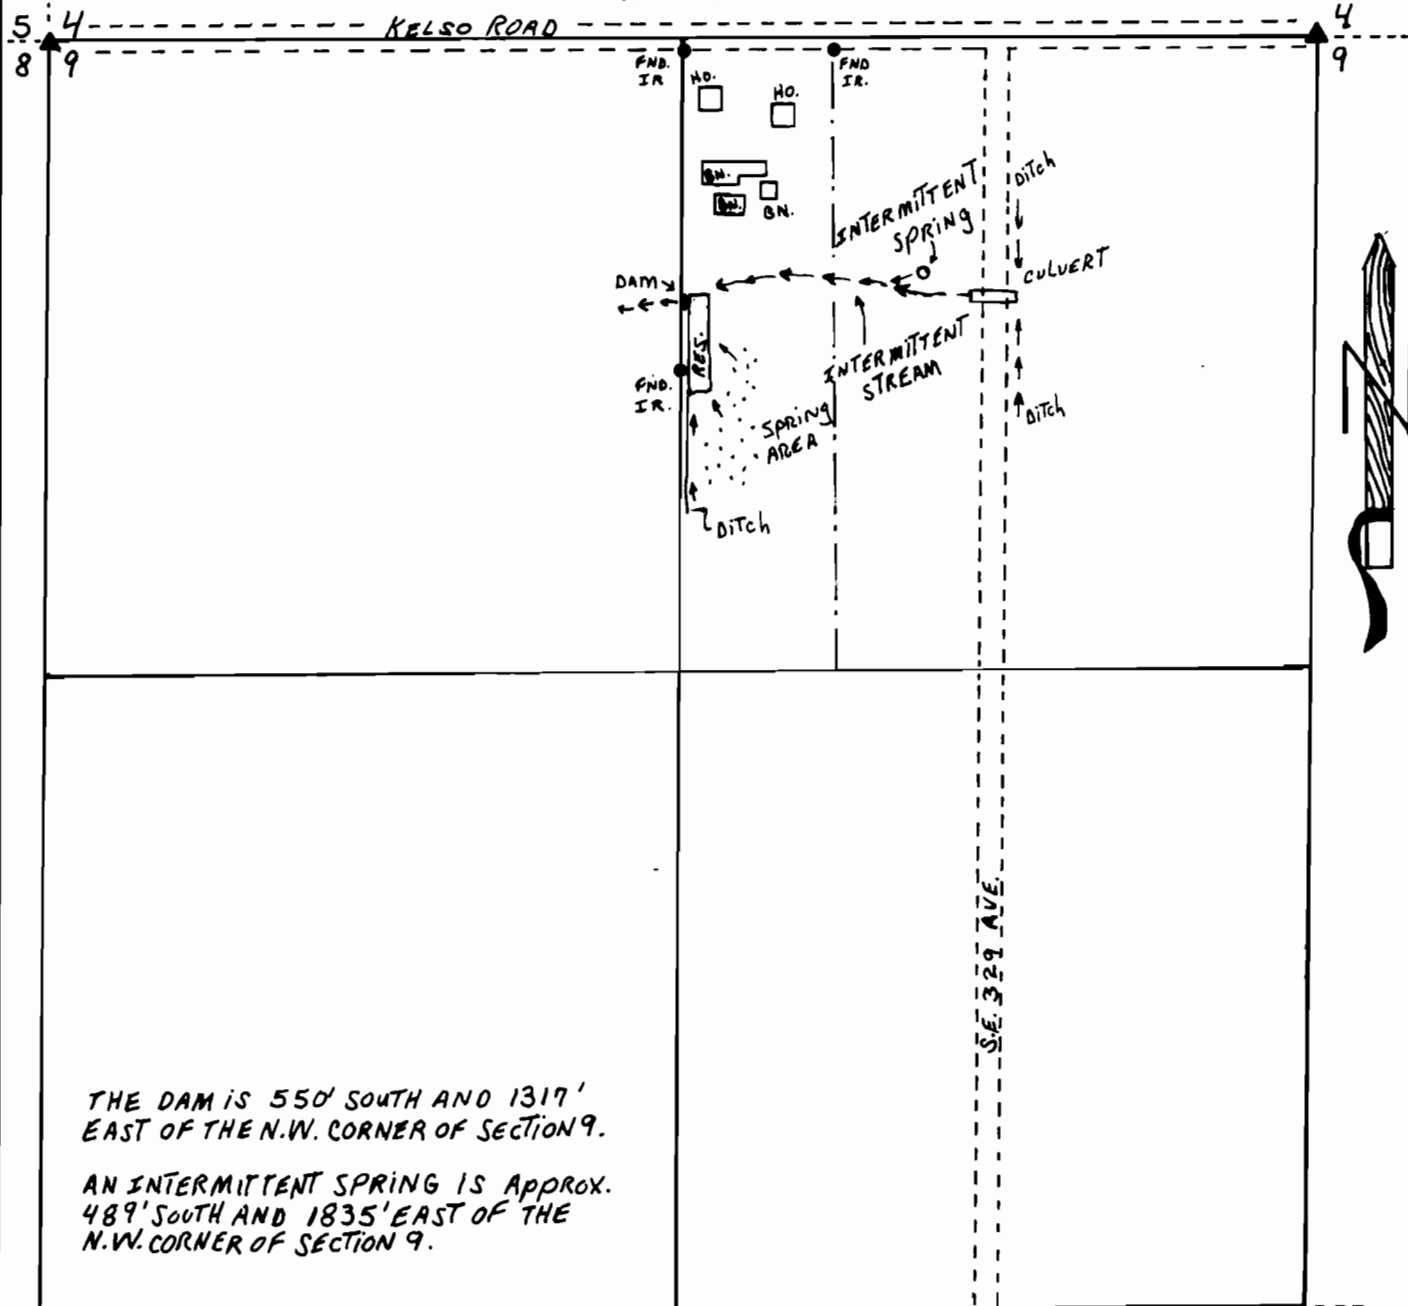

Basis of bearing P.S. #10612

SURVEYED MAY 17, 2004

APPLICATION # R73356

PERMIT # R11560

