

RECEIVED

T.37 S. R.06 W. W.M. SECTION 4 MAR 16 2000


FINAL PROOF SURVEY

UNDER APPLICATION No. R-81556 PERMIT No. R-12151


WATER RESOURCES DEPT.
SALEM, OREGON

IN NAME OF **ILA M. CROOK**

SURVEYED MARCH 9, 2000 by JONATHAN C. SPERO

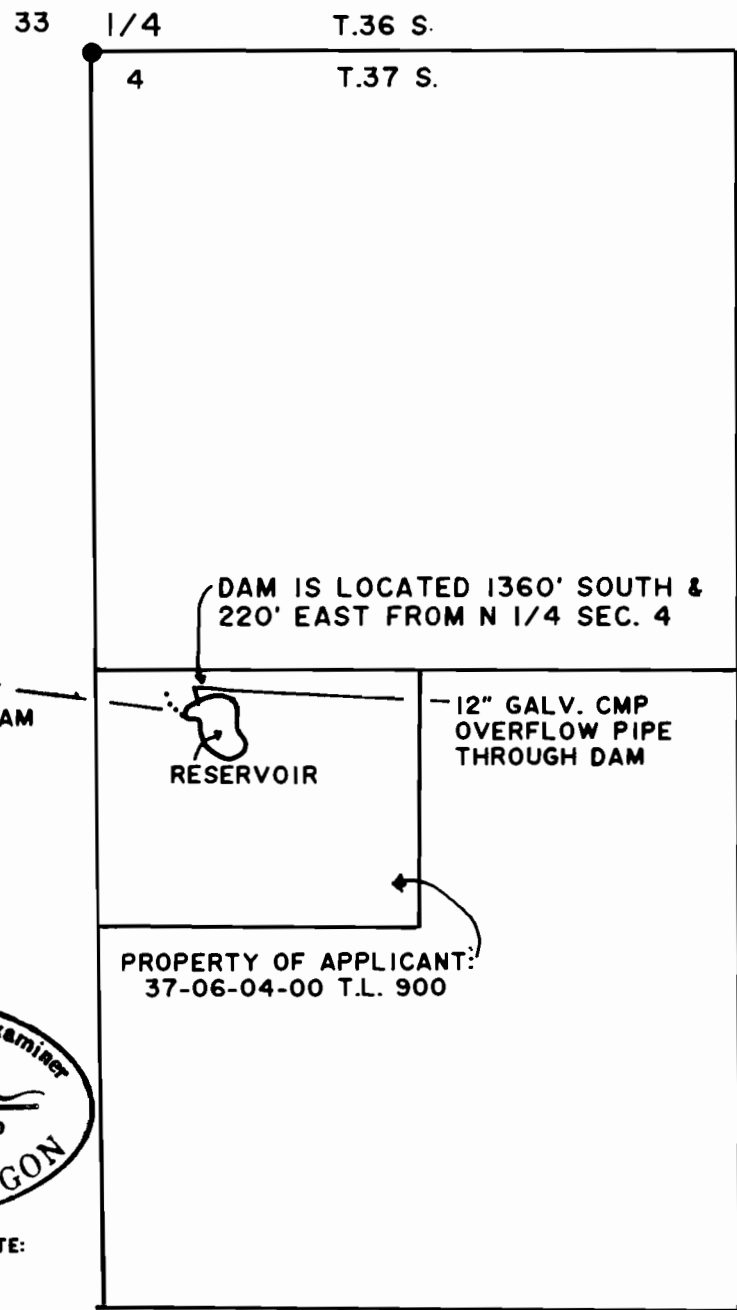

SCALE: 1" = 400'

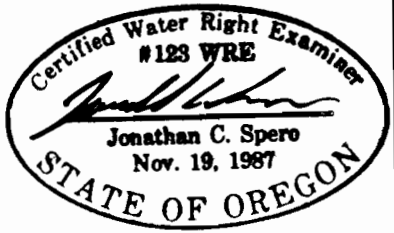

PROPERTY OF APPLICANT:
37-06-04-00 T.L. 900

**PREPARED BY:
JONATHAN C. SPERO C.W.R.E. 123
1002 KINCAID RD./P.O. BOX 16
WILLIAMS, OREGON 97544
PH. (541) 846-6845**

THIS MAP IS FOR THE PURPOSE OF IDENTIFYING THE LOCATION OF THE WATER RIGHT ONLY, AND IS NOT INTENDED TO PROVIDE LEGAL DIMENSIONS OR LOCATIONS OF PROPERTY OWNERSHIP LINES.