

CLAIM OF BENEFICIAL USE MAP

UNDER APPLICATION R-81938; PERMIT R-12304

SW1/4 SE1/4 SEC 2 T 37S R 44E W.M.


U.S.G.S. QUAD - RATTLESNAKE CANYON, DREG. - 7 1/2'



Expires 12/31/02


LEGEND

- RESERVOIR
- == ROAD
- CHANNEL

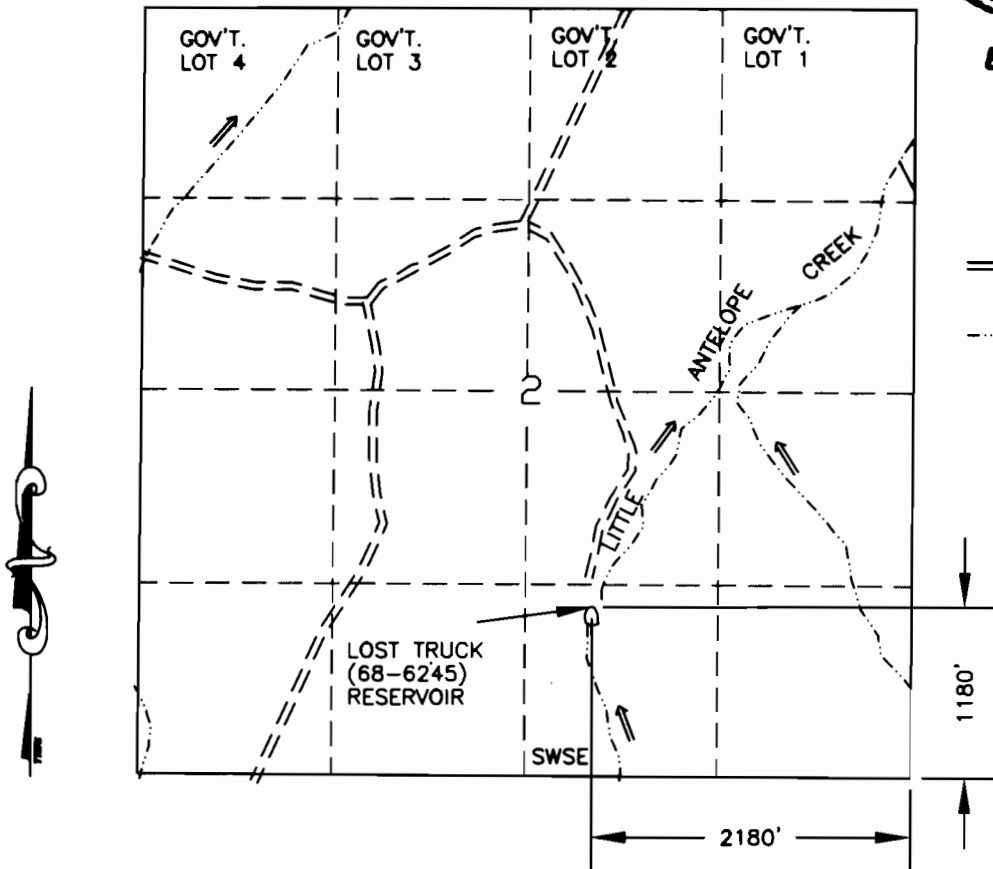

LOST TRUCK (68-6245) RESERVOIR

RECEIVED
SEP 21 1988
BUREAU OF LAND MANAGEMENT

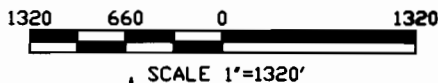

I, [Signature], Acting ADM Operations/Field Services agree to the findings of the CWRE and do submit this site report and map as my Claim of Beneficial Use of the water as provided under the terms and conditions of my Permit R-12304.



THIS MAP IS FOR THE PURPOSE OF LOCATING A WATER RIGHT AND IS NOT INTENDED TO PROVIDE LEGAL DIMENSIONS FOR LOCATION OF PROPERTY BOUNDARIES.

ACAD14
DWG FILELOSTRUCKBEN

UNITED STATES DEPARTMENT OF THE INTERIOR BUREAU OF LAND MANAGEMENT DIVISION OF OPERATIONS VALE DISTRICT	
LOST TRUCK (68-6245) RESERVOIR	
DRAWN BY: <u>[Signature]</u>	
SURVEYED: <u>[Signature]</u>	
APPROVED: <u>[Signature]</u> ADM OPERATIONS AND FIELD SERVICES	
DRAWN: CG	SCALE: 1"=1320'
DATE: 10/18/00	SHEET 1 OF 1
DRAWING NO. OR-03-9172.45-1059	