



# FINAL PROOF SURVEY

A DRAWING PREPARED FOR DOUGLAS H. BRAZIL TO ACCOMPANY HIS CLAIM FOR A RIGHT OF BENEFICIAL USE UNDER PERMIT NO. 51201 FOR SURFACE WATER FROM FLORENCE CREEK IN SECTION 19, TOWNSHIP 5 SOUTH, RANGE 10 WEST OF THE WILLAMETTE MERIDIAN, TILLAMOOK COUNTY, OREGON.

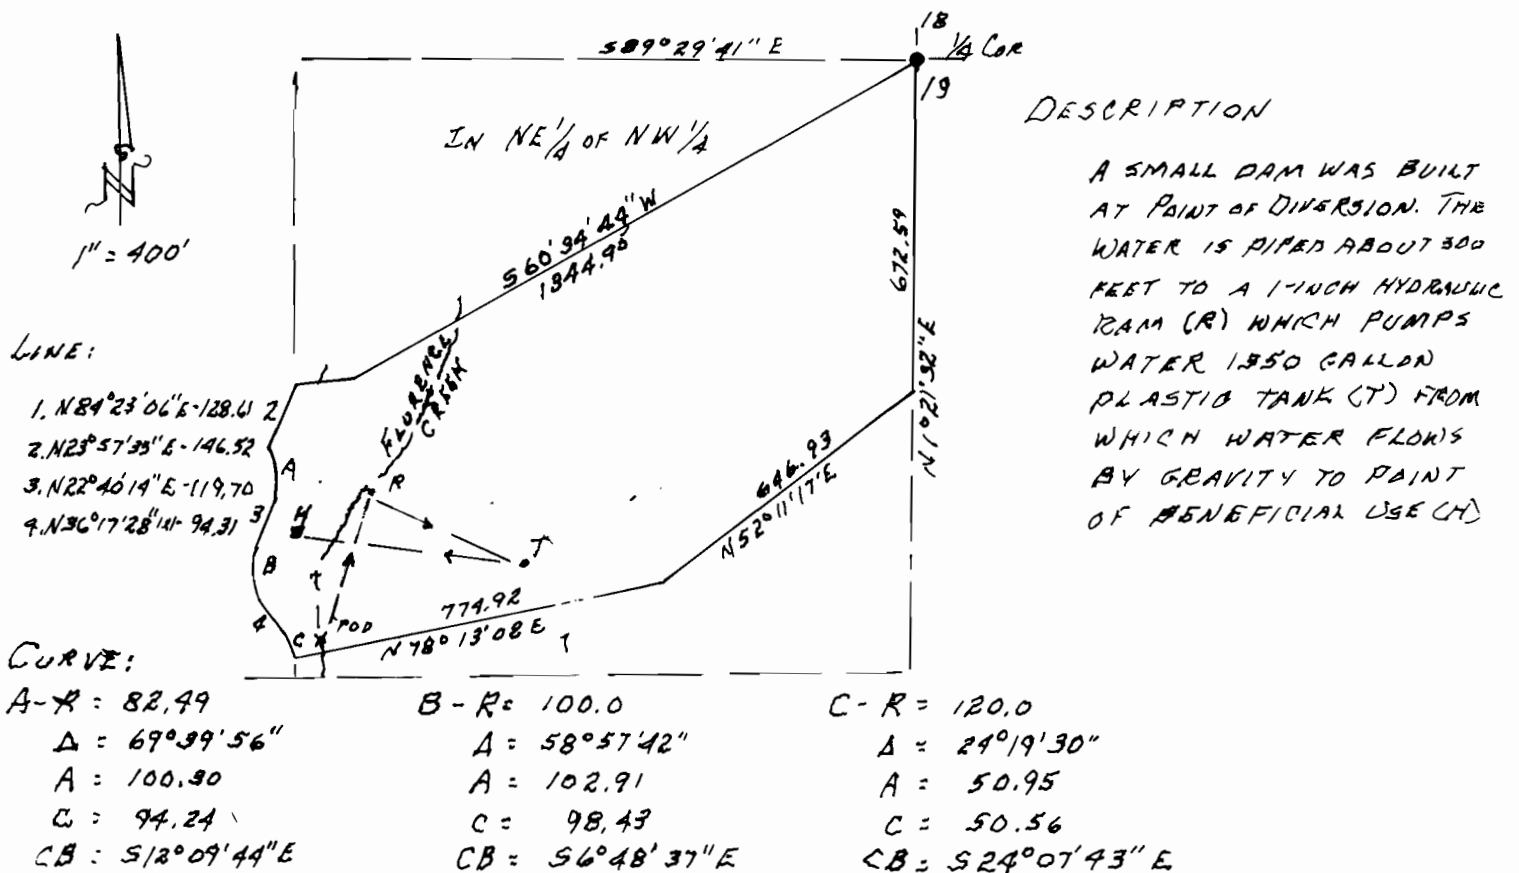

## LOCATION NORTH 1/4 CORNER:

PT. OF DIV. - 1197' SOUTH, 1236' WEST  
 RESIDENCE - 972' SOUTH, 1262' WEST  
 HYDRAULIC RAM (R) - 902' SOUTH, 1134' WEST  
 TANK (T) - 1062' SOUTH, 811' WEST

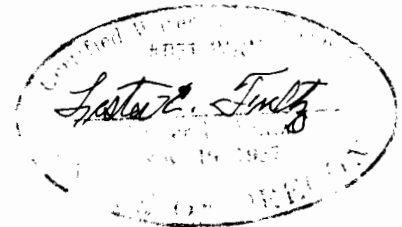

## CERTIFICATE.

THE FINAL PROOF SURVEY AND INSPECTION WAS FOUND TO BE COMPLETED UNDER THE TERMS & CONDITIONS OF PERMIT NO. 51201 BY ME ON JULY 29, 1995. THE FACTS CONTAINED ON THIS MAP, THE FINAL PROOF SURVEY NARRATIVE AND THE WRITTEN FINAL PROOF STATEMENT ARE CORRECT TO THE BEST OF MY KNOWLEDGE.

Lester J. Finley, WRE # 051