


FINAL PROOF SURVEY

A DRAWING PREPARED FOR DOUGLASH H. BRAZIL TO ACCOMPANY HIS CLAIM FOR A RIGHT OF BENEFICIAL USE UNDER PERMIT NO. 51283 FOR SPRING WATER WHICH FLOWS INTO FLORENCE CREEK IN THE NW 1/4 OF SECTION 19, TOWNSHIP 5 SOUTH, RANGE 10 WEST OF THE WILLAMETTE MERIDIAN, TILLAMOOK COUNTY, OREGON.

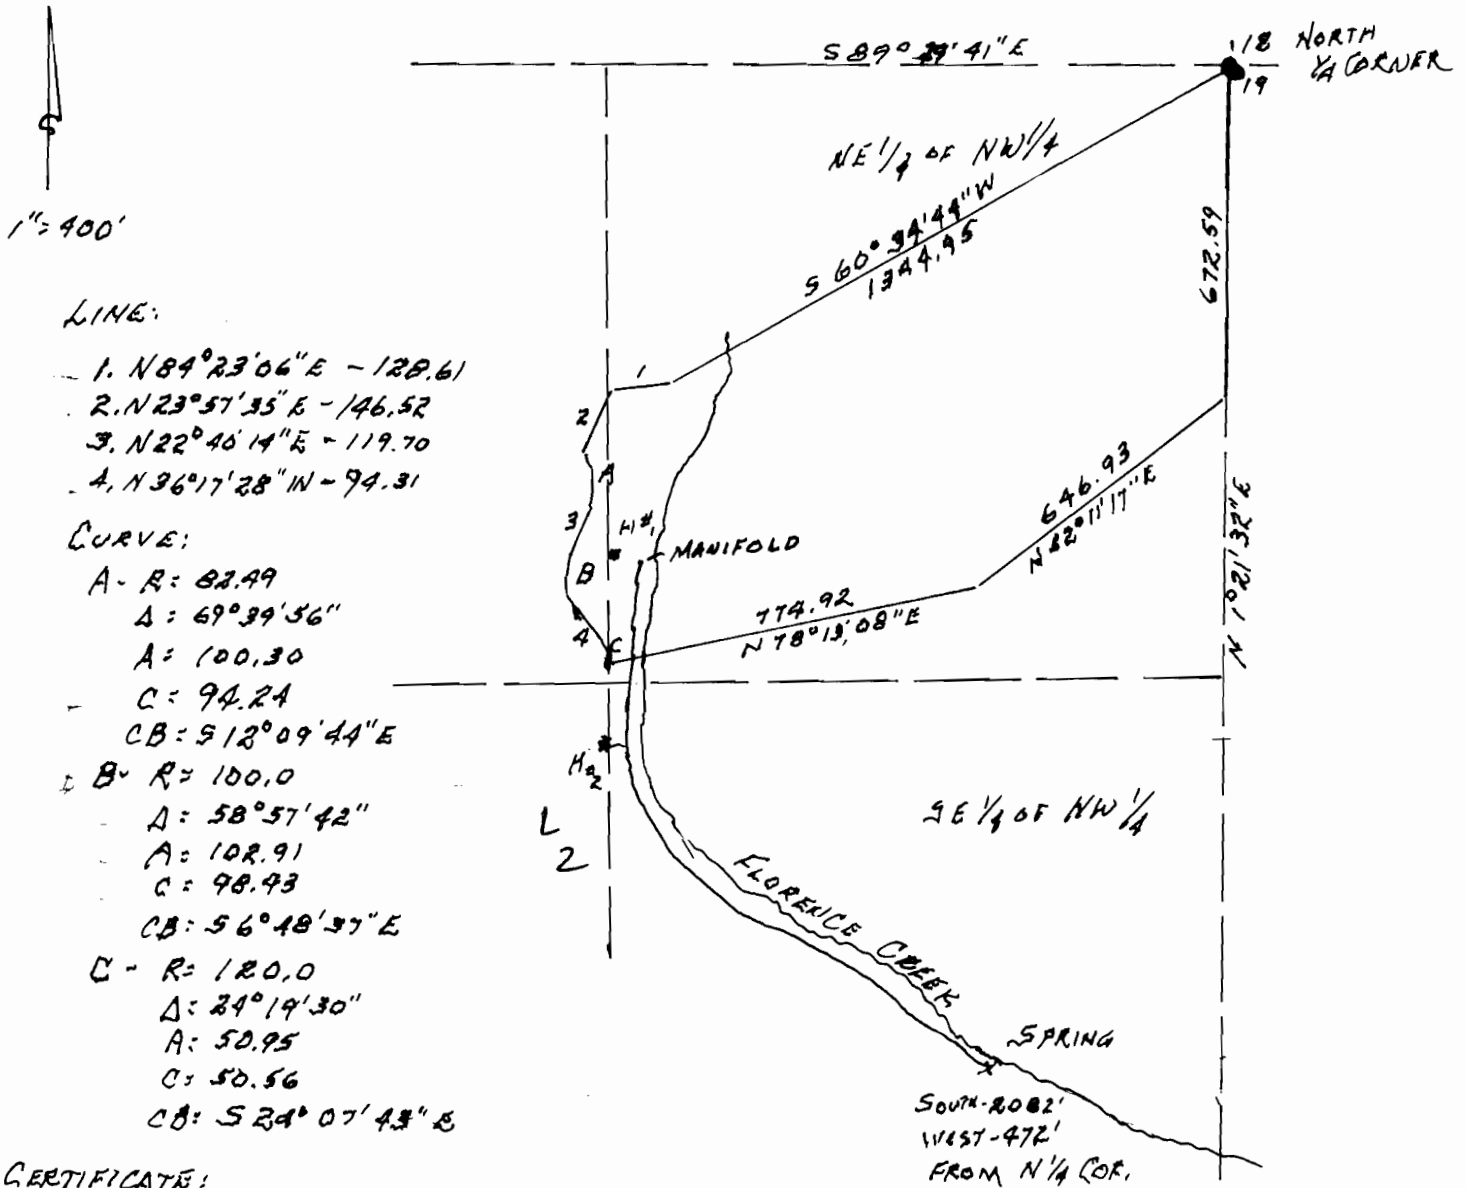

CERTIFICATE:

THE FINAL PROOF SURVEY & INSPECTION WAS FOUND TO BE COMPLETED UNDER THE TERMS & CONDITIONS OF PERMIT NO. 51283 BY ME ON JULY 29, 1995. THE FACTS CONTAINED ON THIS MAP, THE FINAL PROOF SURVEY NARRATIVE & THE WRITTEN FINAL PROOF STATEMENT ARE CORRECT TO THE BEST OF MY KNOWLEDGE.

Lester E. Fultz, CURE #051

Amended by WRD staff to include GSD LOT number, 6-3-08 JWG

