


**T. 2 N., R. 10 E., W.M.**

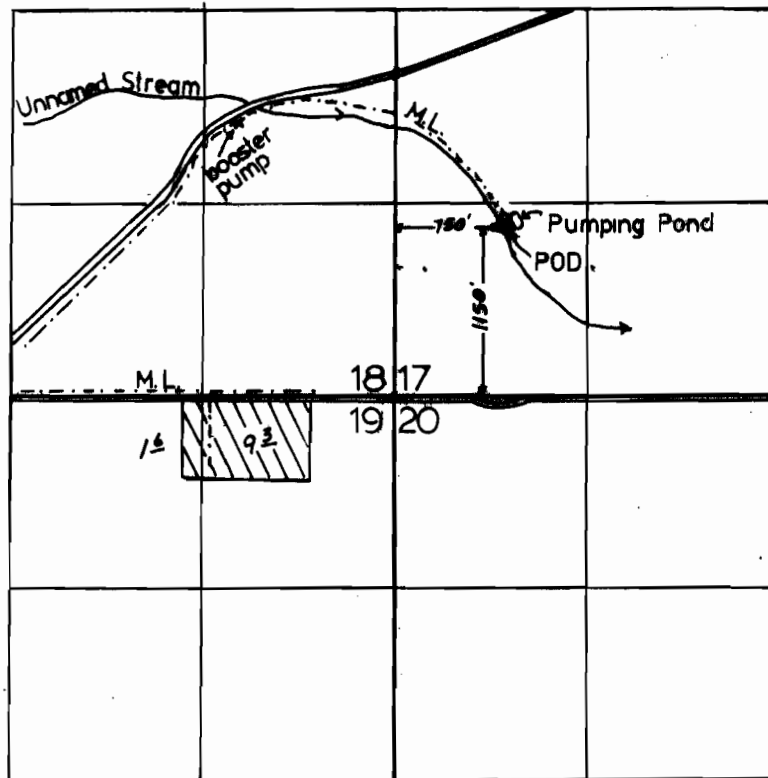

**FINAL PROOF SURVEY**

UNDER

Transfer 4263

IN NAME OF

**George Akiyama**

Surveyed SEPTEMBER 30, 1993, by I. MILLER