


T. 39 S., R. 4 E., W.M.

RECEIVED  
AUG 27 1998  
WATER RIGHTS DIVISION  
PORTLAND, OREGON

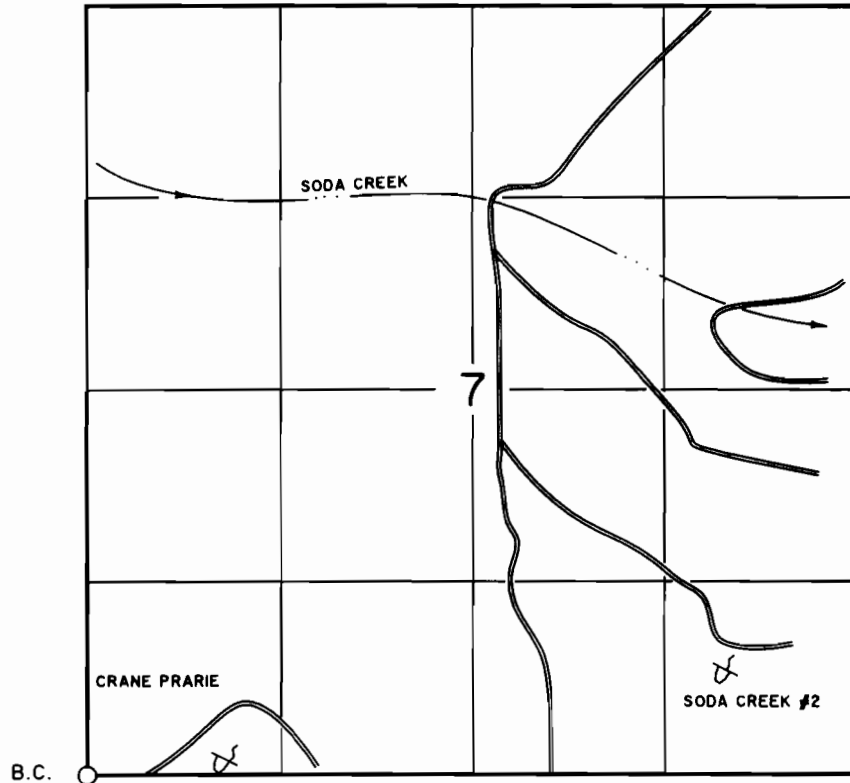

B.C. ○  
DIVERSION IS 45 FEET NORTH AND 900 FEET EAST OF THE SW CORNER OF SECTION 7.

DIVERSION IS 710 FEET NORTH AND 4380 FEET EAST OF THE SW CORNER OF SECTION 7.


### FINAL PROOF MAP

IN NAME OF

## UNITED STATES BUREAU OF LAND MANAGEMENT

APPLICATION NO. S-79235

PERMIT NO. 53045

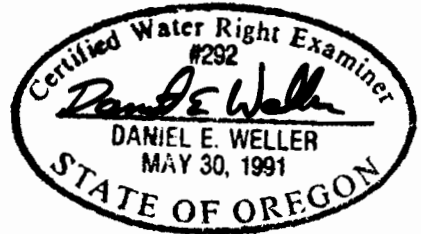

SURVEYED: JULY 14, 1998

EXPIRES 6/30/00

THE PURPOSE OF THIS MAP IS FOR IDENTIFYING THE LOCATION OF THE WATER RIGHT ONLY AND IS NOT INTENDED TO PROVIDE LEGAL DIMENSIONS OR LOCATION OF PROPERTY OWNERSHIP LINES.

WRE 6200A, 6201A OREGON

U.S. BUREAU OF LAND MANAGEMENT-OSO  
BRANCH OF GEOGRAPHIC SCIENCES  
DWG: SODAI

EXECUTED BY:  
DANIEL E. WELLER, PLS, CWRE  
P.O. BOX 2965  
PORTLAND, OREGON 97208