


T. 41 S., R. 5 E., W.M.

RECEIVED

FEB - 2 1998

WATER RESOURCES DEPT.
SALEM, OREGON

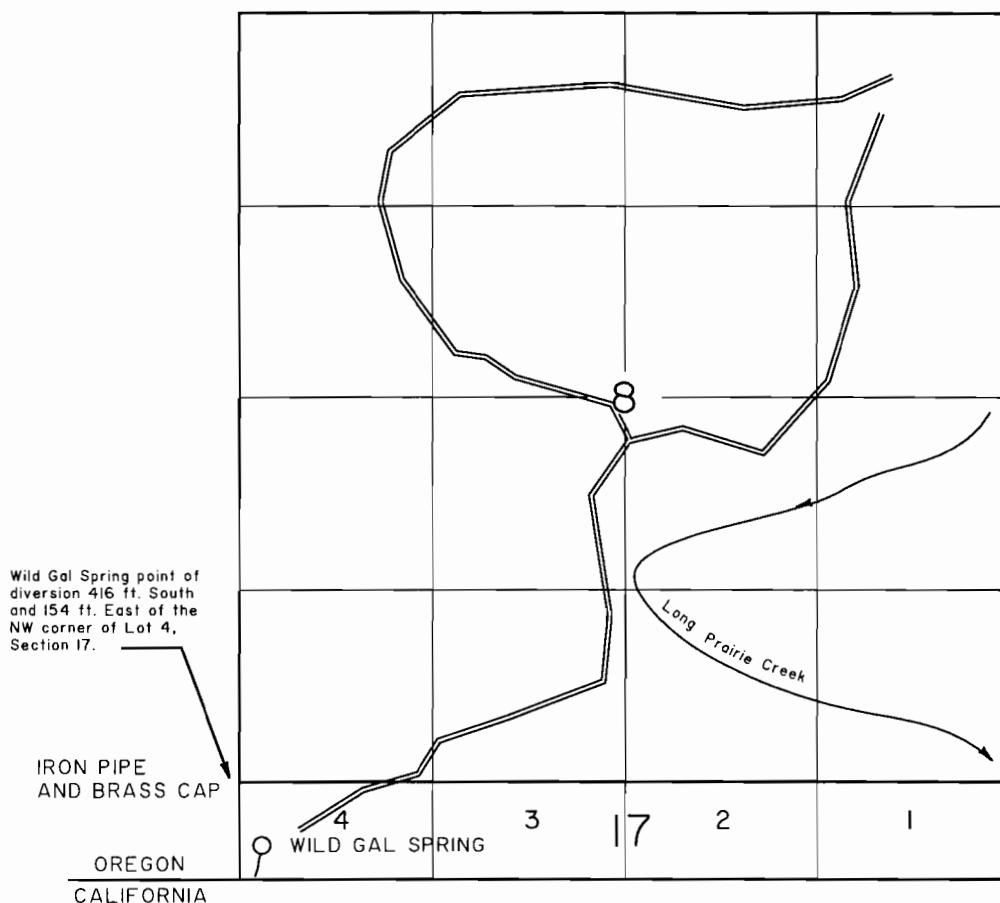

1" = 1320'

FINAL PROOF MAP
UNDER

APPLICATION NO. S-74470 PERMIT NO. 52951

IN NAME OF
UNITED STATES BUREAU OF LAND MANAGEMENT

SURVEYED: AUGUST 13, 1997

THE PURPOSE OF THIS MAP IS FOR IDENTIFYING THE LOCATION OF THE WATER RIGHT ONLY AND
IS NOT INTENDED TO PROVIDE LEGAL DIMENSIONS OR LOCATION OF PROPERTY OWNERSHIP LINES.

BLM PROJECT NO. 6512

DWG: WILDGAL

WRE 6075

U.S. BUREAU OF LAND MANAGEMENT-OSO
BRANCH OF CADASTRAL SURVEY
LETTER OF AUTHORIZATION
DATED: AUGUST 29, 1997

EXECUTED BY:
DANIEL E. WELLER, PLS, CWRE
P.O. BOX 2965
PORTLAND, OREGON 97208

