



FINAL PROOF SURVEY MAP T28S, R6W, WM

SCALE 1" = 1320'


DOUGLAS COUNTY

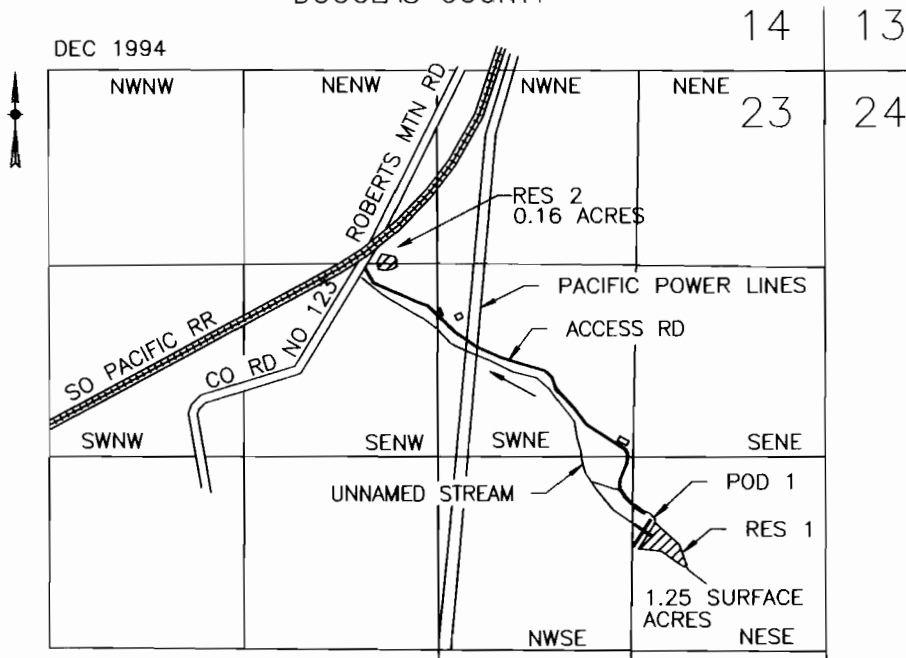

POD 1 IS 3060 FT S AND 1170 FT W FROM NE COR SEC 23
POD 2 IS 1360 FT S AND 3060 FT W FROM NE COR SEC 23

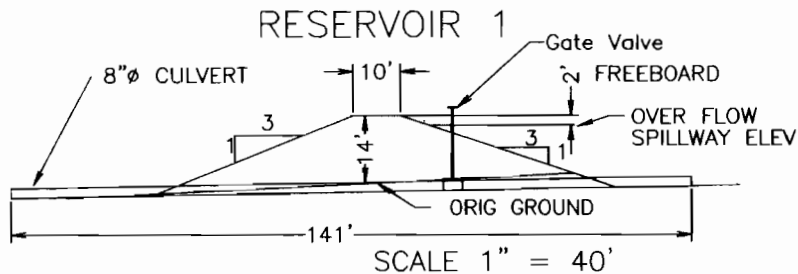

RESERVOIR 2

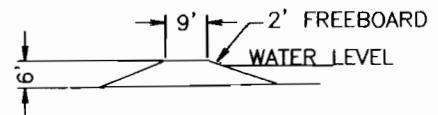

FINAL PROOF SURVEY UNDER

Application No. R-80560 Permit No. R-11912

IN NAME OF

Elizabeth A Crain, President

Whispering Oaks Ranch, Inc.

Surveyed September 20, 2000 by M E Farr

THIS IS A LOCATION MAP FOR A FINAL PROOF SURVEY BY WHISPERING OAKS RANCH, INC. THIS MAP IS FOR THE PURPOSE OF IDENTIFYING THE LOCATION OF THE WATER RIGHT ONLY AND IS NOT INTENDED TO PROVIDE LEGAL DIMENSIONS OR LOCATIONS OF PROPERTY OWNERSHIP LINES.

MAP PREPARED FOR:
ELIZABETH A CRAIN, Pres
WHISPERING OAKS RANCH, INC.
936 ROBERTS CREEK ROAD
ROSEBURG, OR 97470

MAP PREPARED BY:
MAURICE E FARR, CWRE
395 NE KIRBY AVENUE
ROSEBURG, OR 97470

