


BENEFICIAL USE MAP FOR GLUCH (68-5635) RESERVOIR

R-69462

NW1/4 SW1/4, SECTION 29, T.31S., R.46E., W.M.
U.S.G.S. QUAD - PARSNIP PEAK, OREG.-IDAHO - 7 1/2'
U.S.G.S. QUAD - JUNIPER RIDGE, OREG. - 7 1/2'

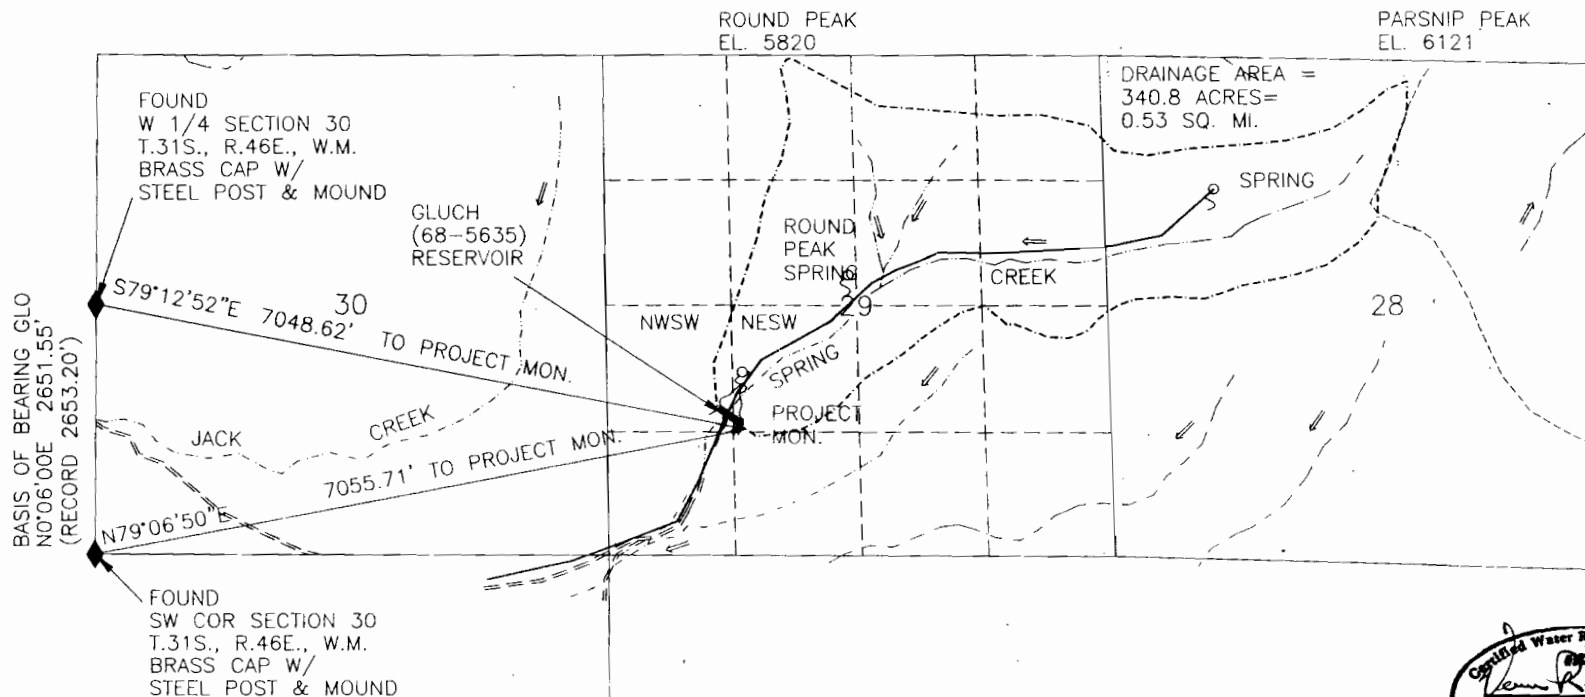

LEGEND

- SECTION LINE
- - - QUARTER SECTION LINE
- - - DRAINAGE AREA
- == CHANNEL
- == ROAD
- == TRAIL
- GLUCH-BLACK BUTTE PIPELINE
- FOUND SECTION CORNER
- RESERVOIR
- SPRING

RECEIVED

SEP 29 2000

WATER RESOURCES DEPT.
SALEM, OREGON

COBU MAP # 0126

I, Gayla M. Ernst, Acting ADM Operations/Field Services agree to the findings of the CWRE and do submit this site report and map as my Claim of Beneficial Use of the water as provided under the terms and conditions of my Permit R-11746.

Gayla M. Ernst

1320 660 0 1320

SCALE 1"=1320'

THIS MAP IS FOR THE PURPOSE OF LOCATING A WATER RIGHT AND IS NOT INTENDED TO PROVIDE LEGAL DIMENSIONS FOR LOCATION OF PROPERTY BOUNDARIES.



REV. NO.	DESCRIPTION	DATE	APPROVED
UNITED STATES DEPARTMENT OF THE INTERIOR BUREAU OF LAND MANAGEMENT DIVISION OF OPERATIONS OREGON STATE OFFICE			
DRAINAGE AREA & BENEFICIAL USE MAP GLUCH(68-5635)RESERVOIR			
DESIGNED			
REVIEWED			
APPROVED	<i>Vernon R. Pritchard</i>		
DRAWN: C.G.	SCALE: 1"=1320'		
DATE: 7/12/00	SHEET 1 OF 1		
DRAWING NO. OR-05-9172 45-1043			

ACA314/SOSK8.0
GLUCHDRN.DWG