



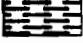

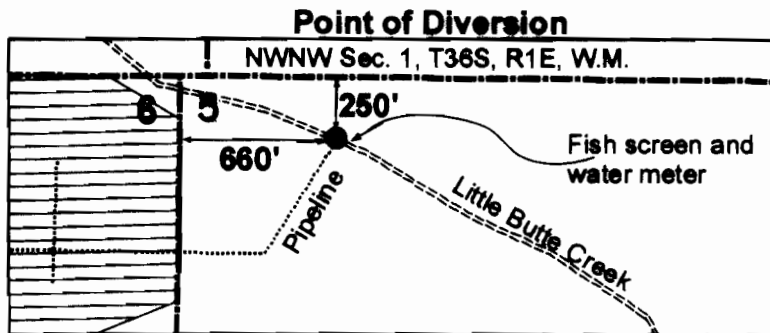


Claim of Beneficial Use Map
 Deborah Lilian Thompson (Gadberry)
 Application T-8829
T 35 S, R 1 E, Sec 31, W.M.
T 36 S, R 1 E, Sec 6, W.M.

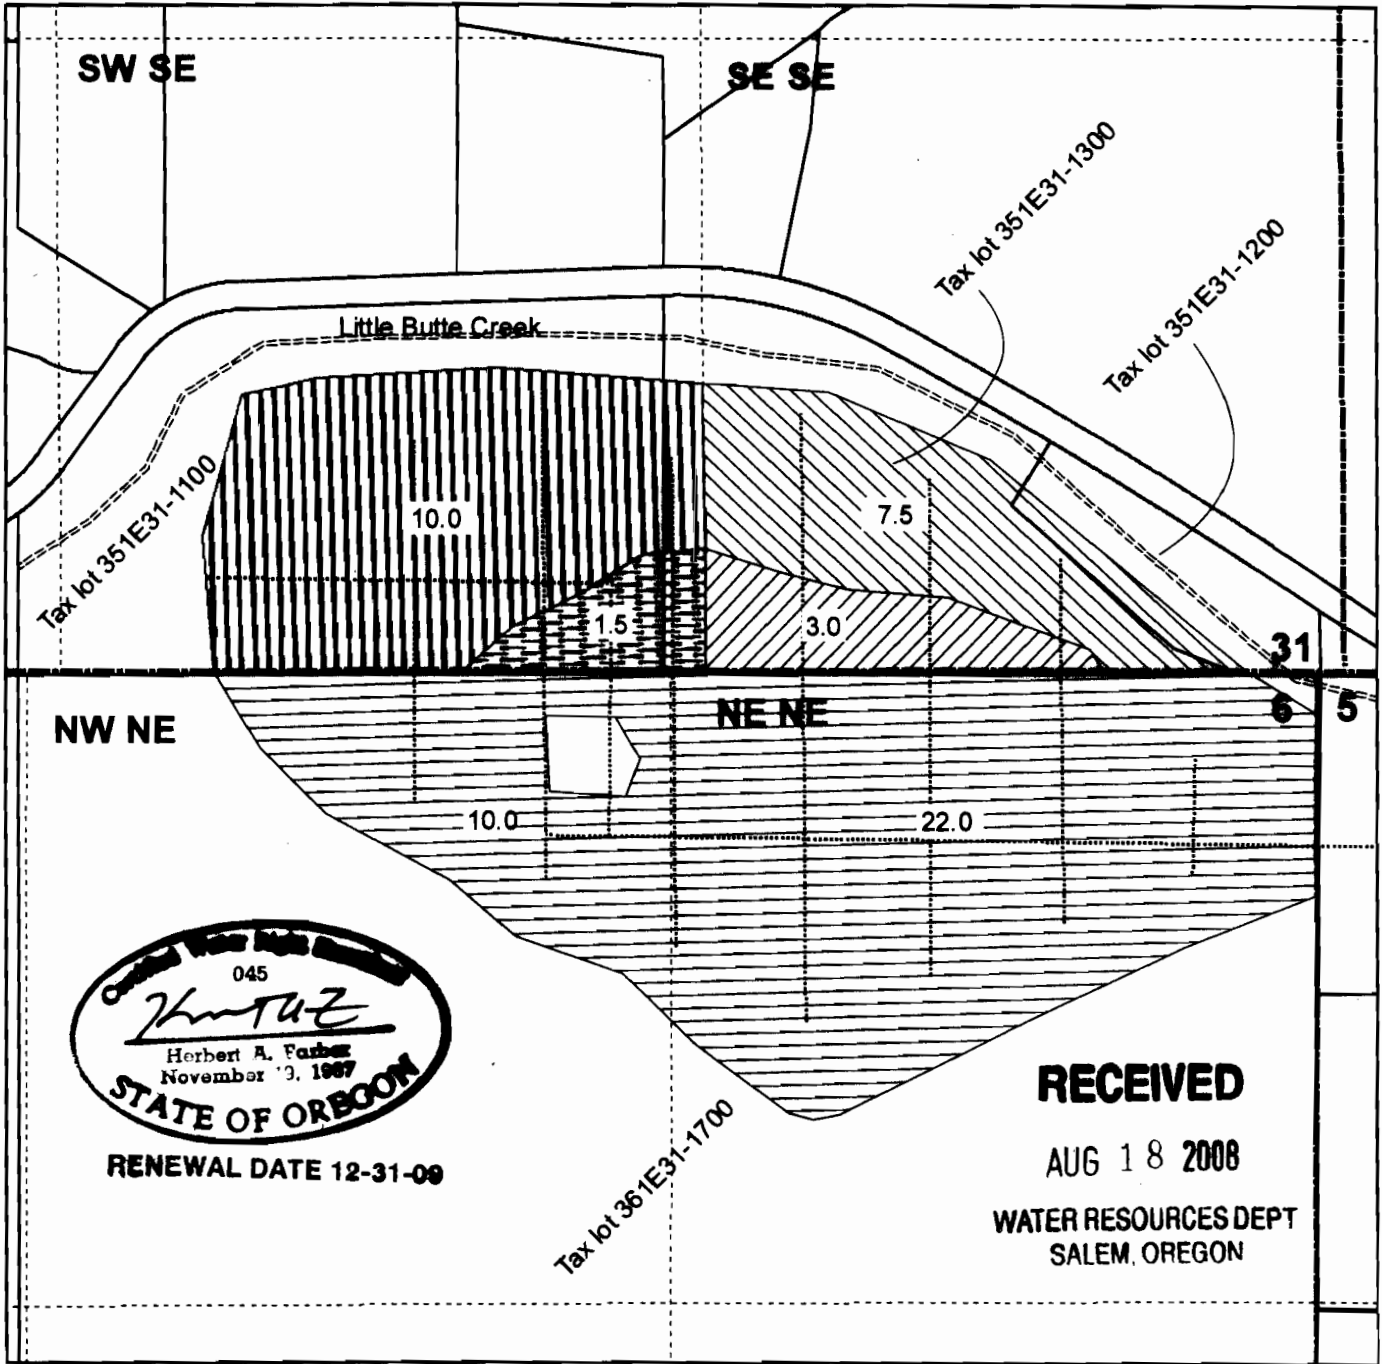


Legend

-  C17163 1885
-  C17163 1908
-  c17164 1885
-  C17170 1885
-  C17170 1908



This map is not intended to provide legal dimensions or locations of property ownership lines.

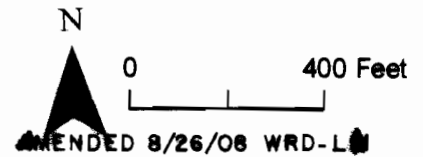

FARBER
 SURVEYING

PO Box 5286
 Central Point, Oregon 97502
 Phone 541-664-5599
 Fax 541-664-5603
 Email hfarber@charter.net

Farber & Sons, Inc.
 431 Oak Street
 Central Point, Oregon
 Fax 541-664-5603
 Tax ID: 93-1057173